


3100

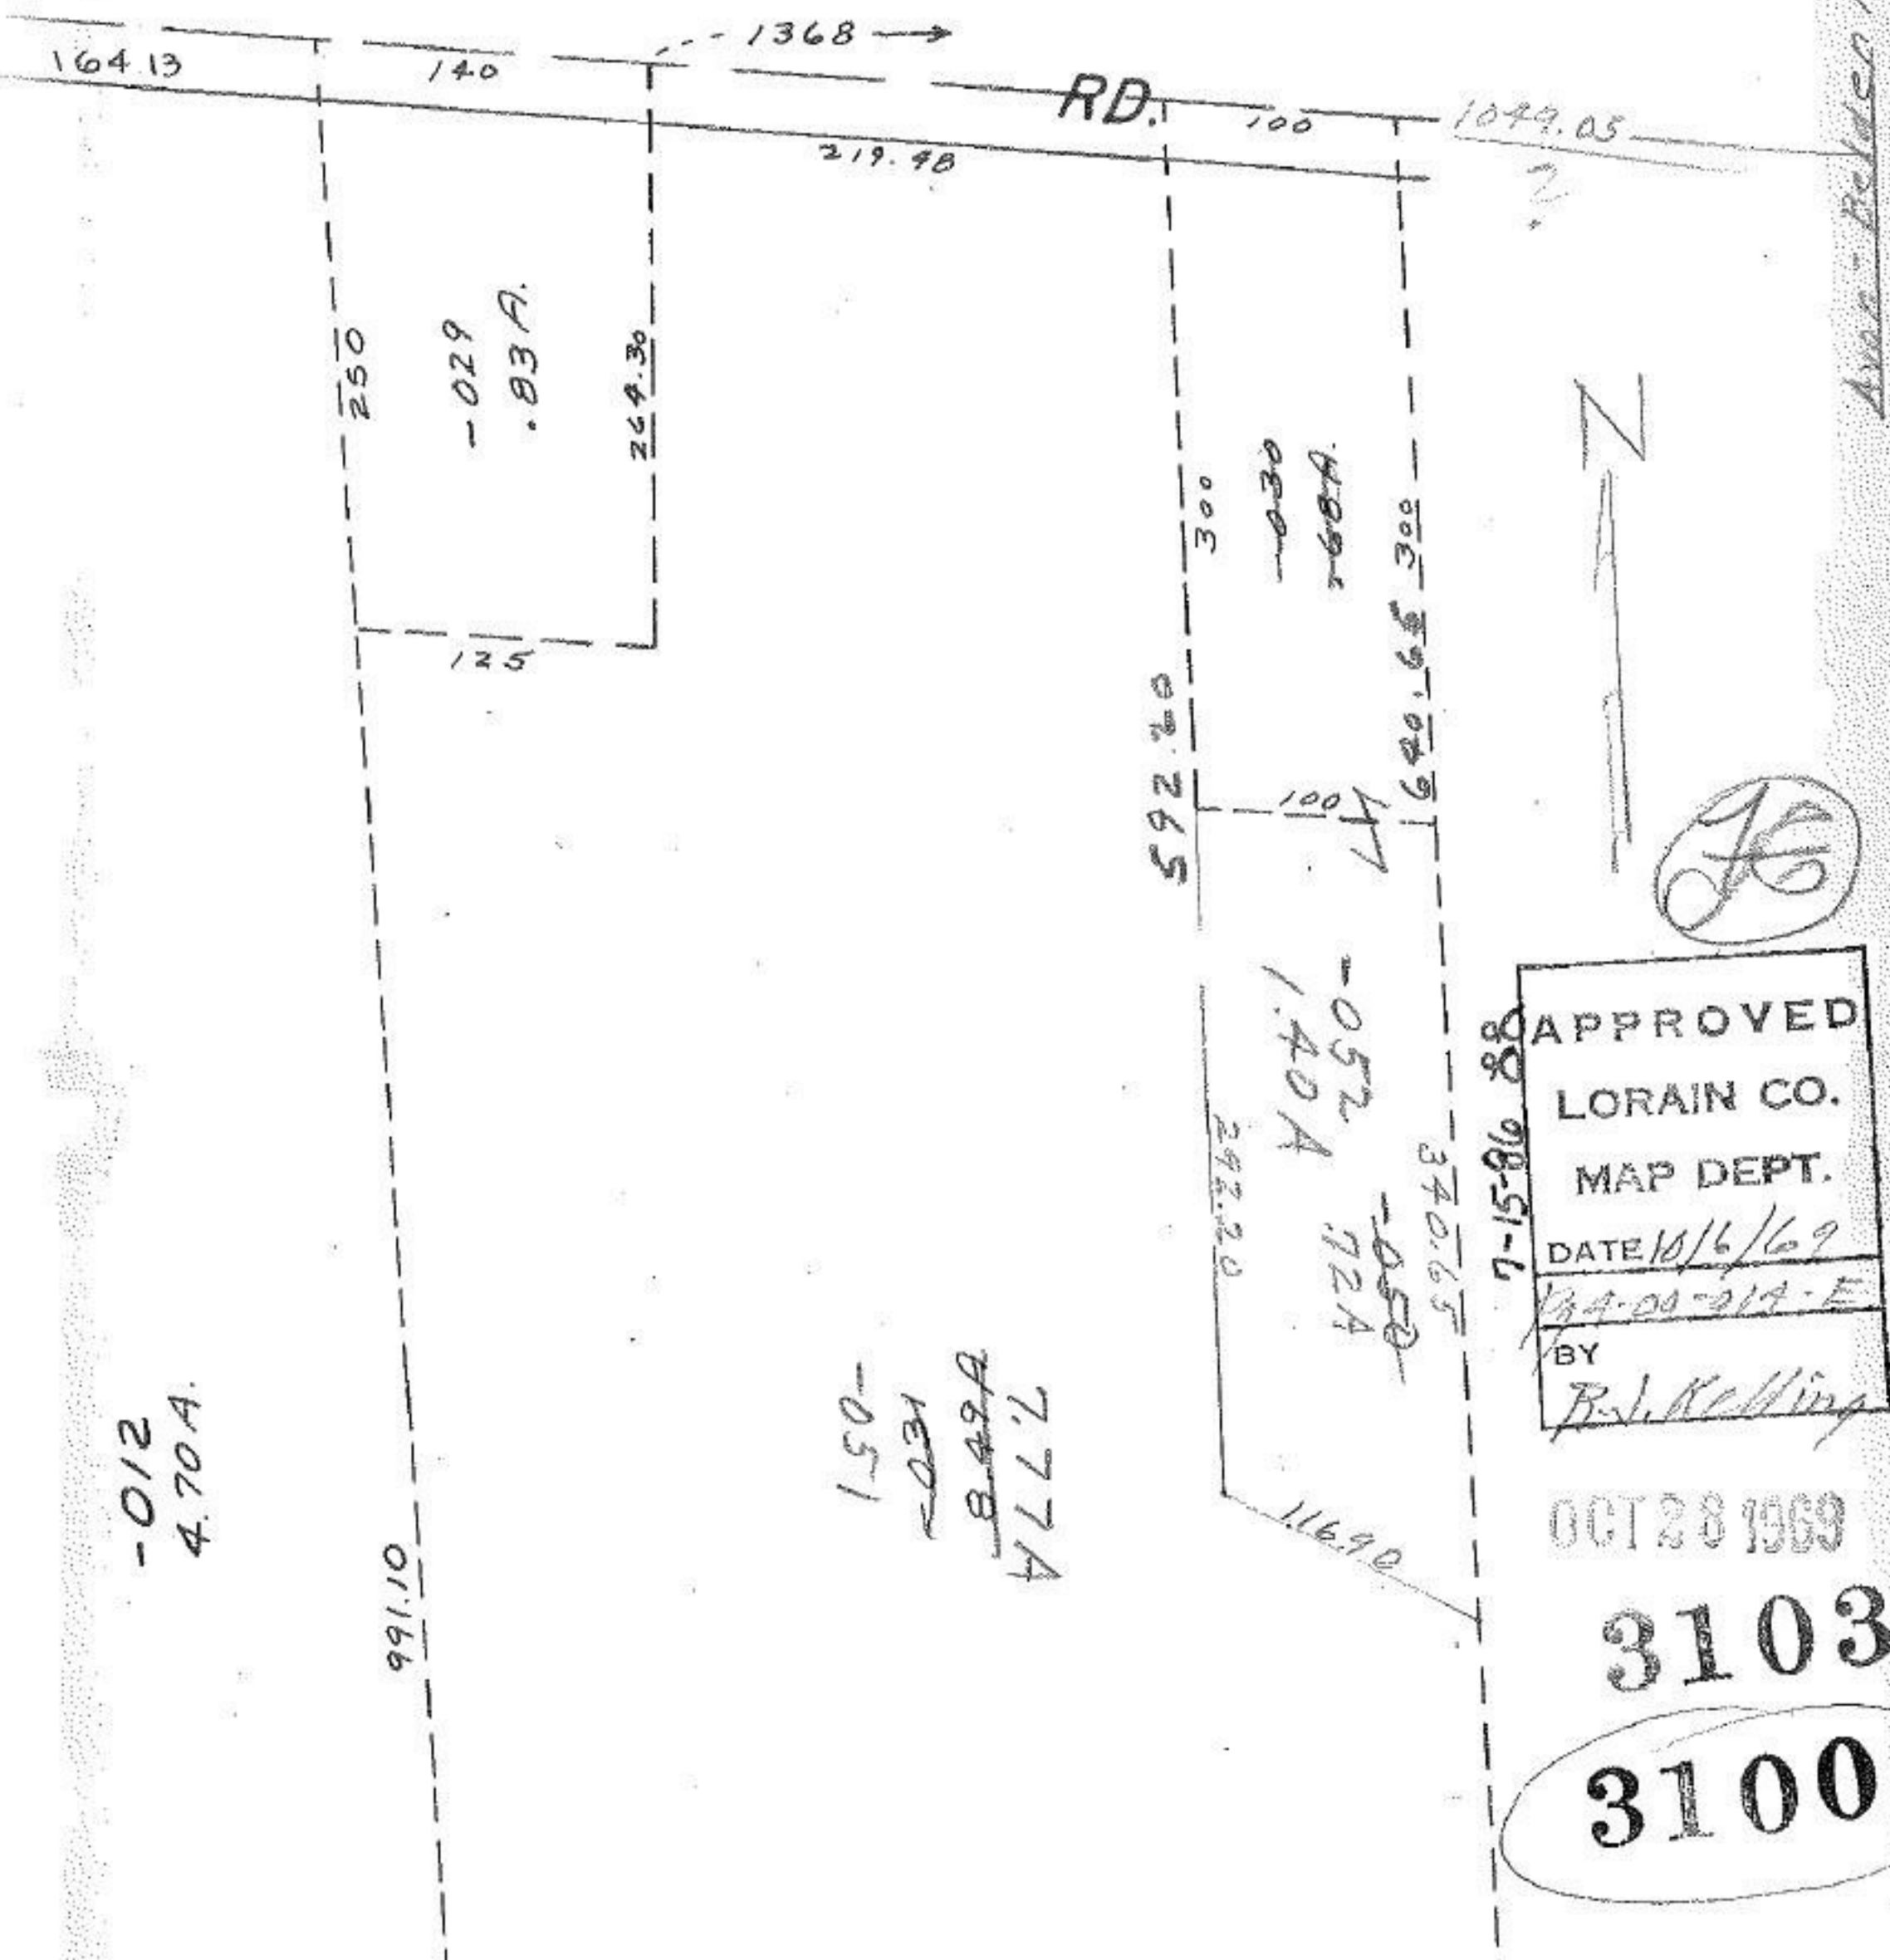

JG

APPROVED
LORAIN CO.
MAP DEPT.
DATE 10/6/69
BY
R. J. Kelling

OCT 28 1969

3103

3100

Away - Belvidere Rd