


3104

76

OHIO

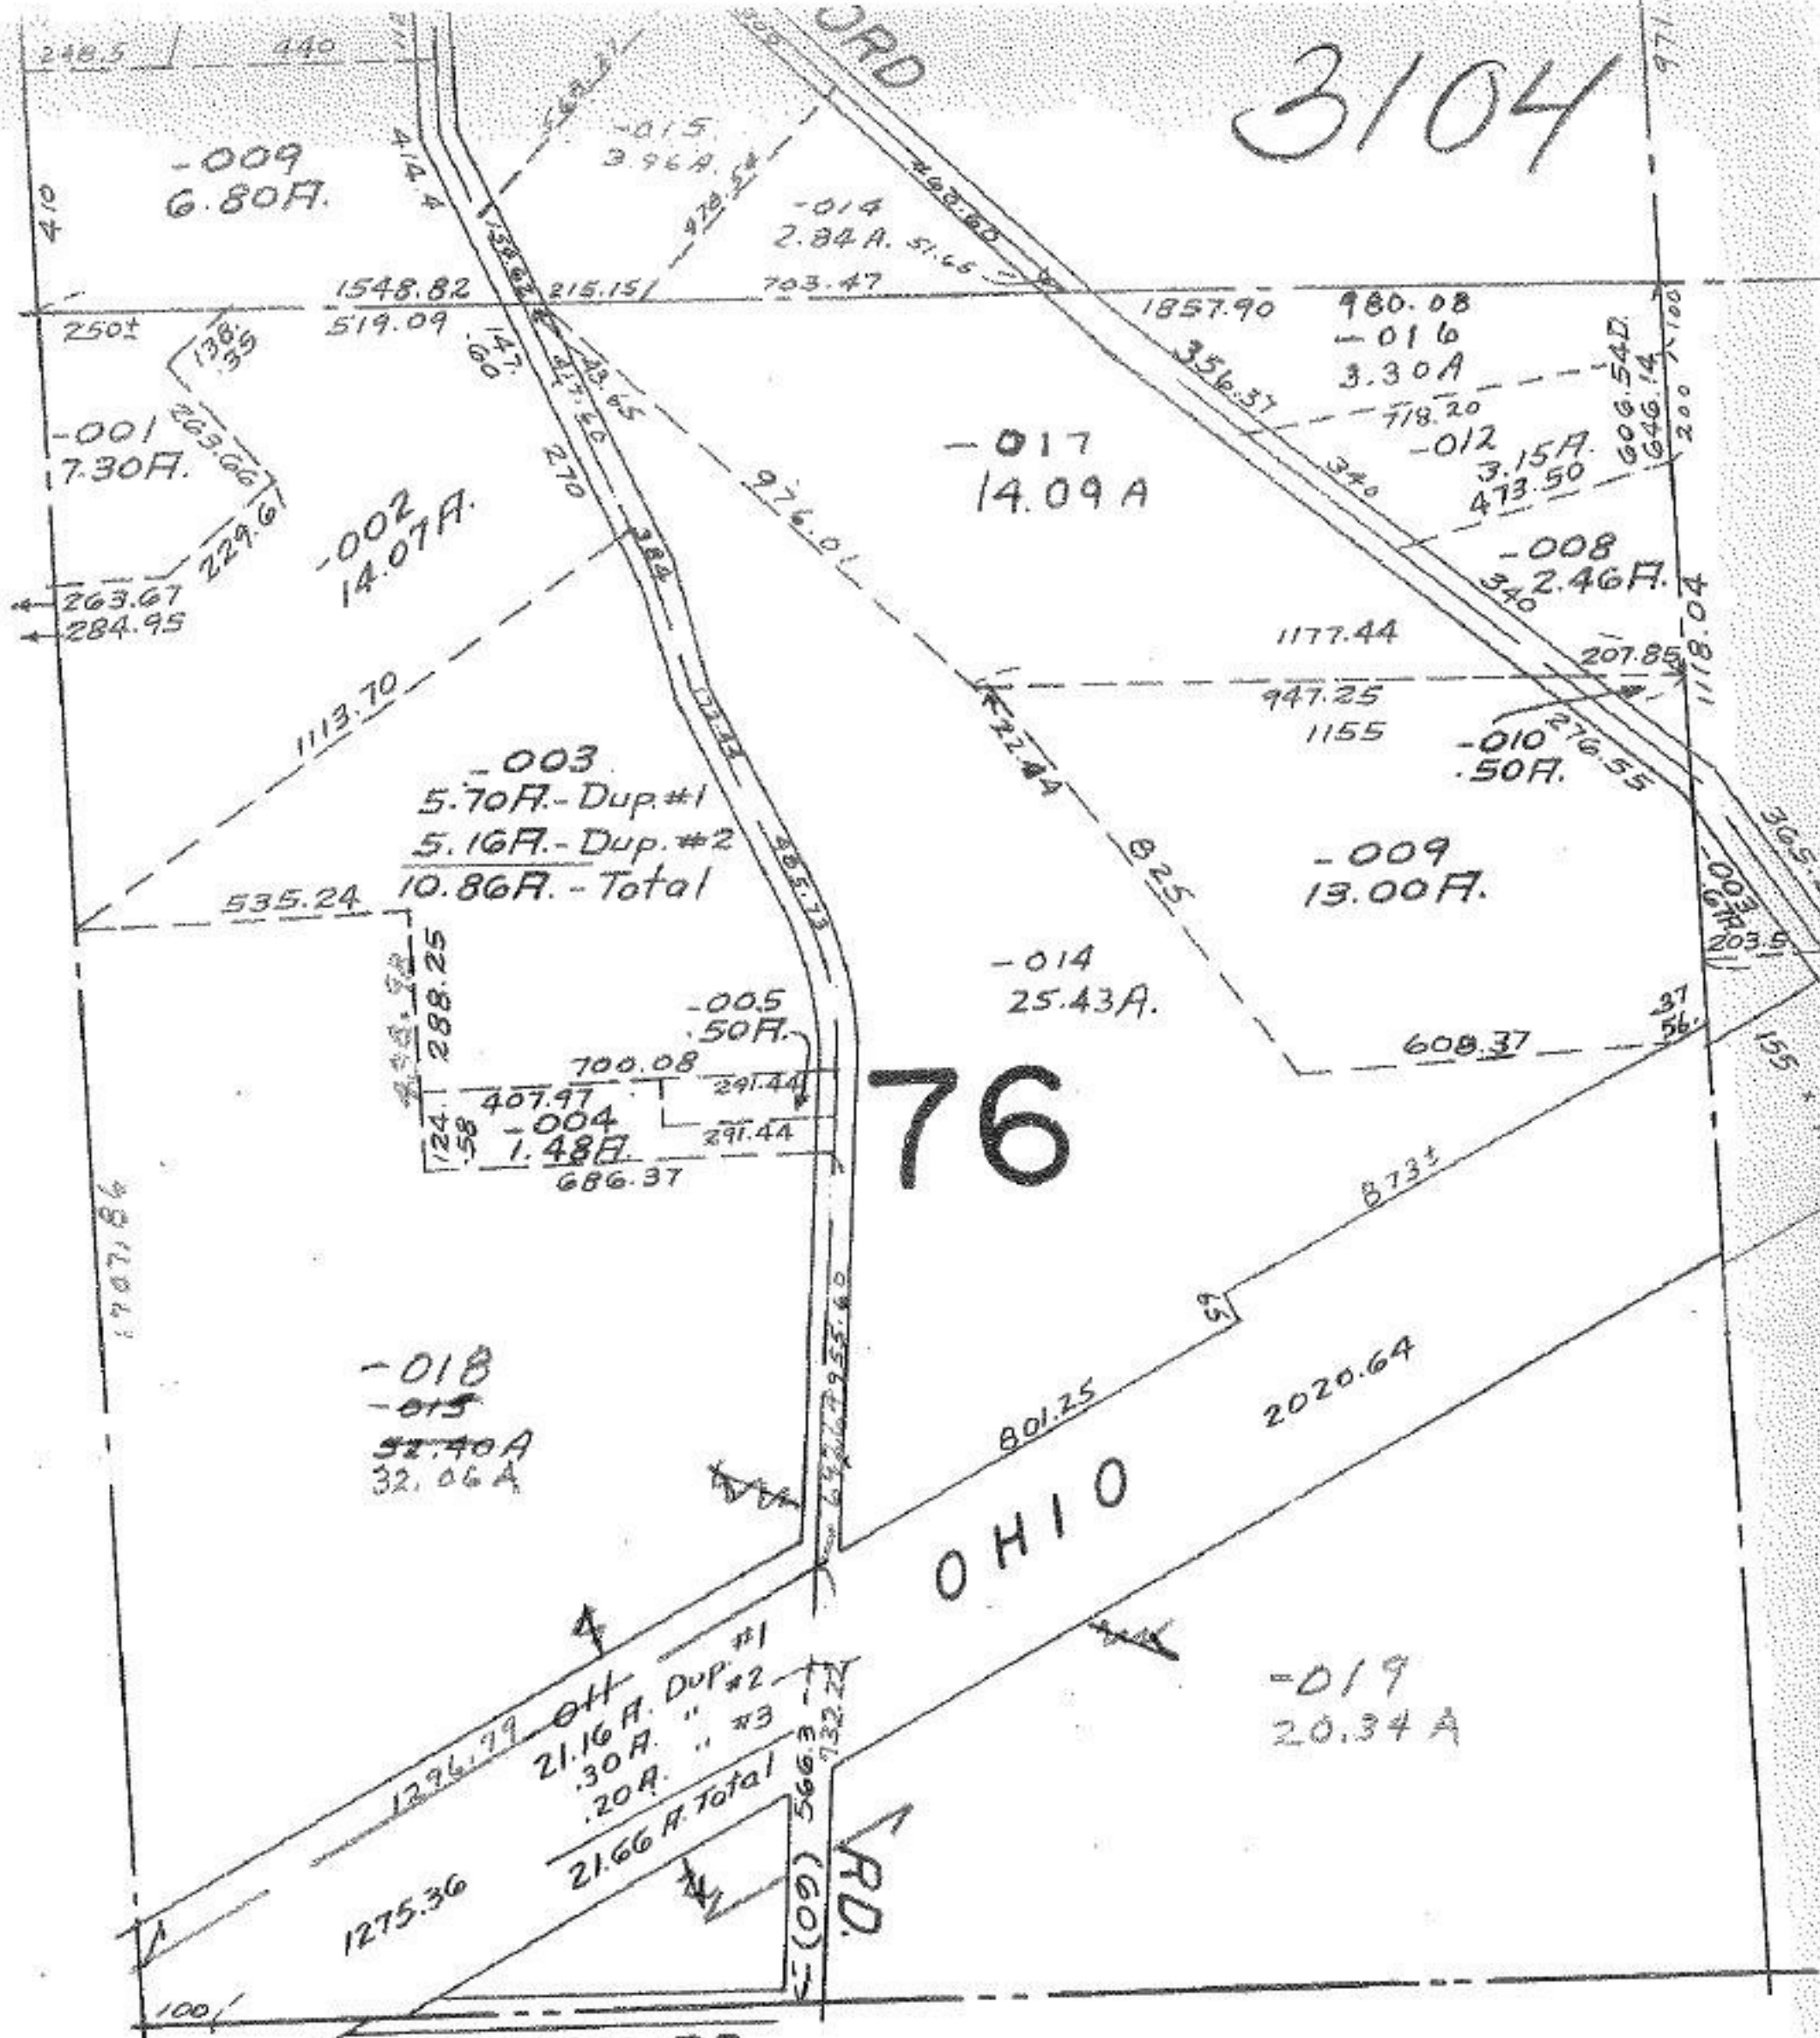

APPROVED
LORAIN CO.

PORTMAN RD.
S. D. 86 OCT 23 1969