


87.98 58.67 117.38 148.80 88.12 58.77 176.38 117.65 58.84

FIELD - FRENCH CREEK

69760

400

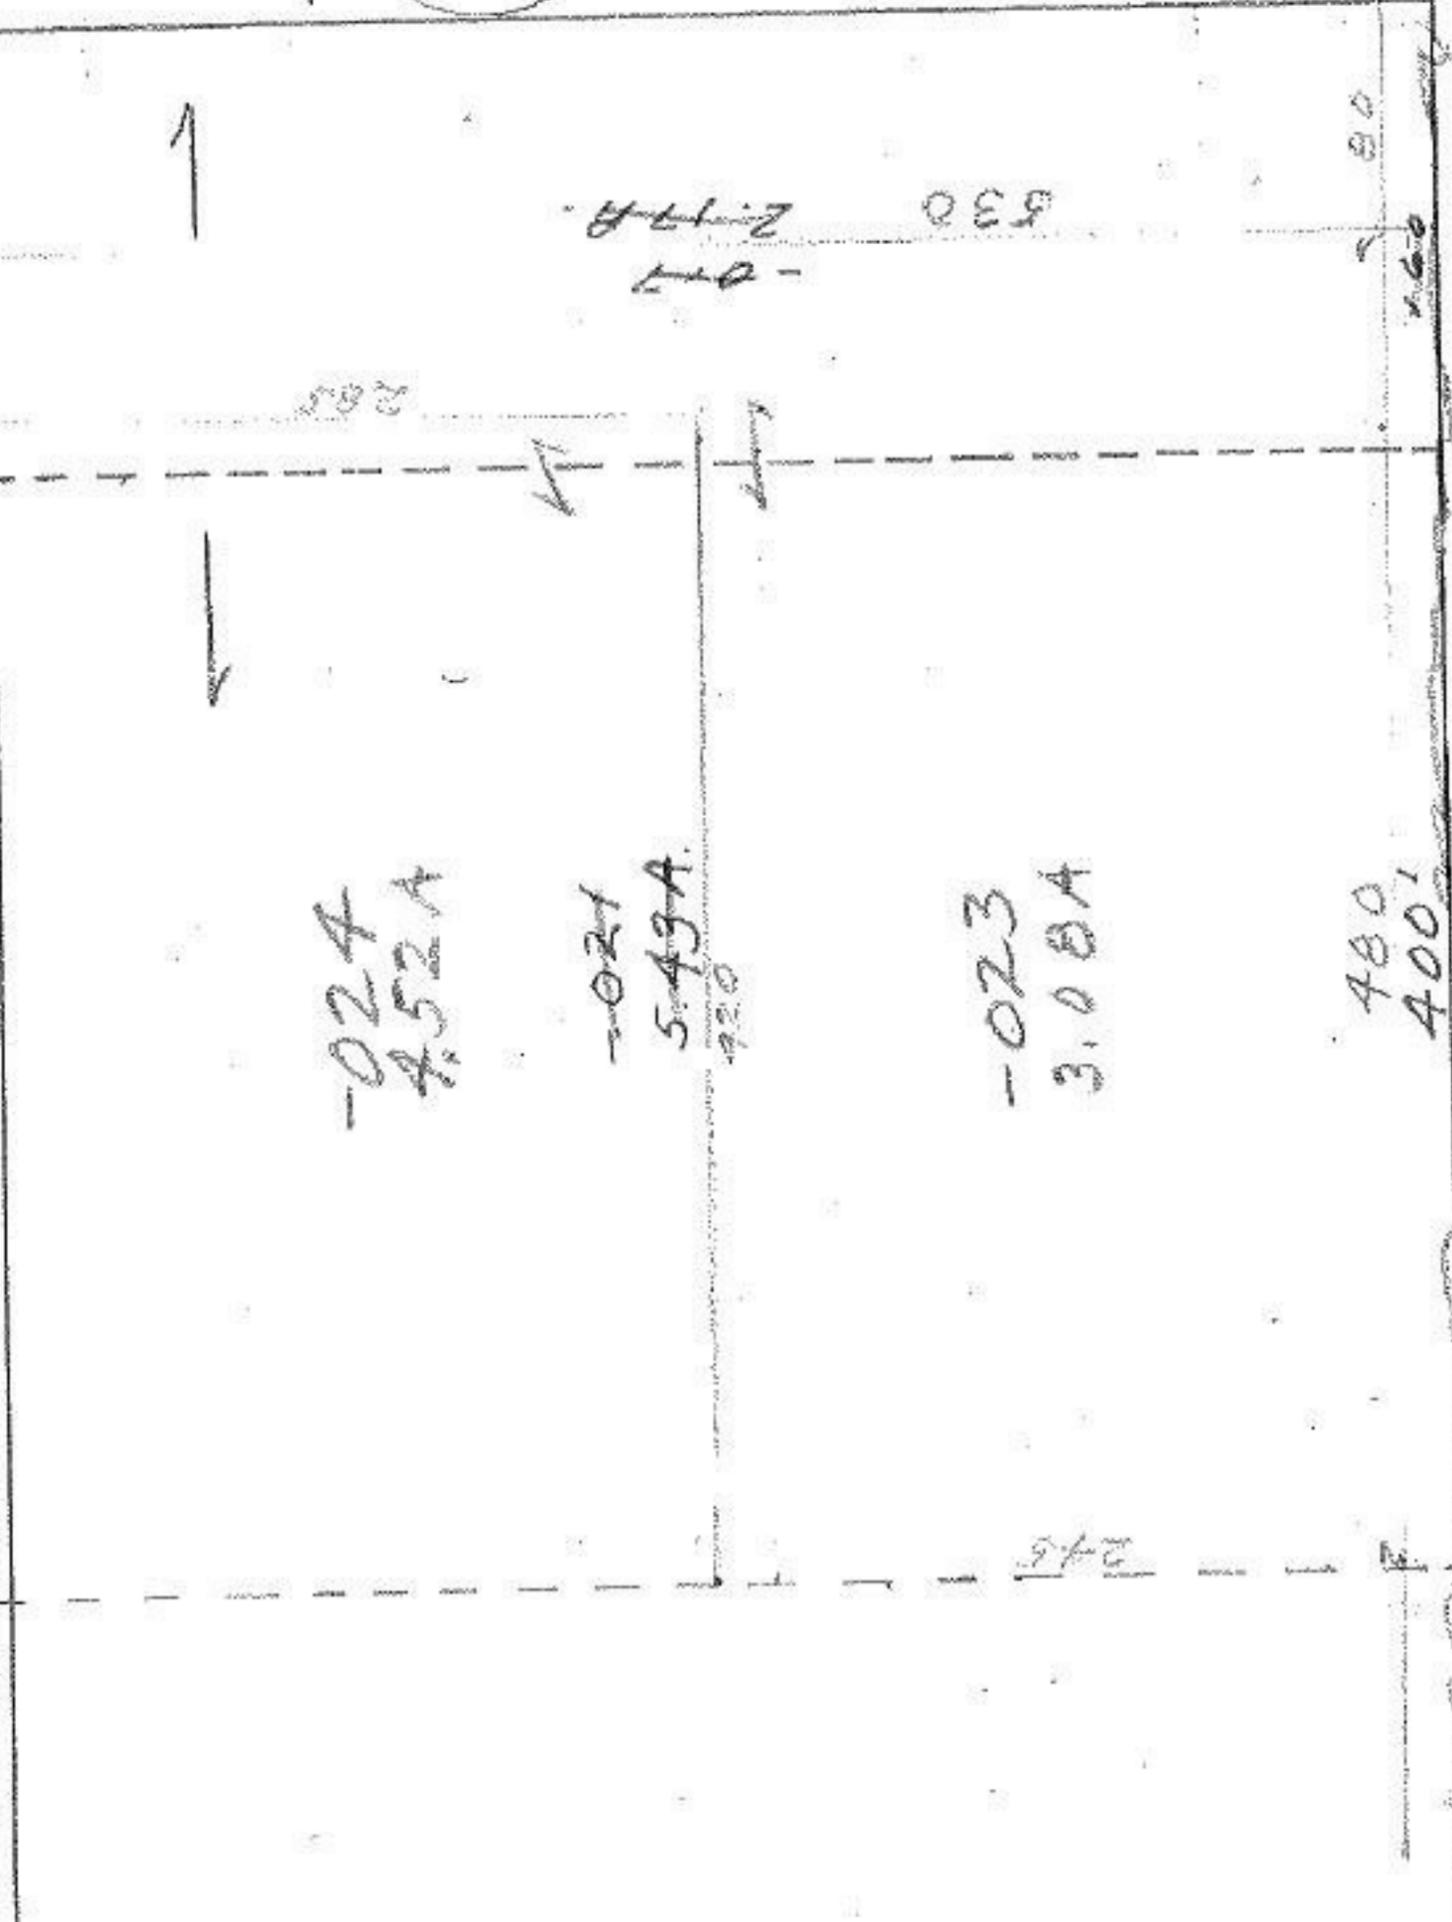

DEC 2 1969

(Handwritten initials)

APPROVED
 LORAIN CO.
 MAP DEPT.
 DATE 10/17/69
 BY R. L. ...

3105

67

3105