

3115

77.33

185.25

935.24

25

794.36

PT-044

PT 1.01 A

-053


234.07

#54

104.94

-054
~~-015~~
15.00A
14.55

S.S.
7-23-56

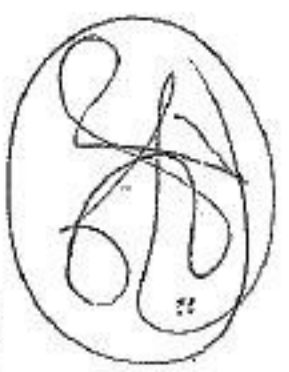

311

APPRO
LORAI
MAP
DATE
BY

