


APPROVED  
 LORAIN CO.  
 MAP DEPT.  
 DATE 10/23/69  
 BY *R. Kellum*

7-16-86  
 S.S.  
 DEC 2 1969  
 Erie

3145

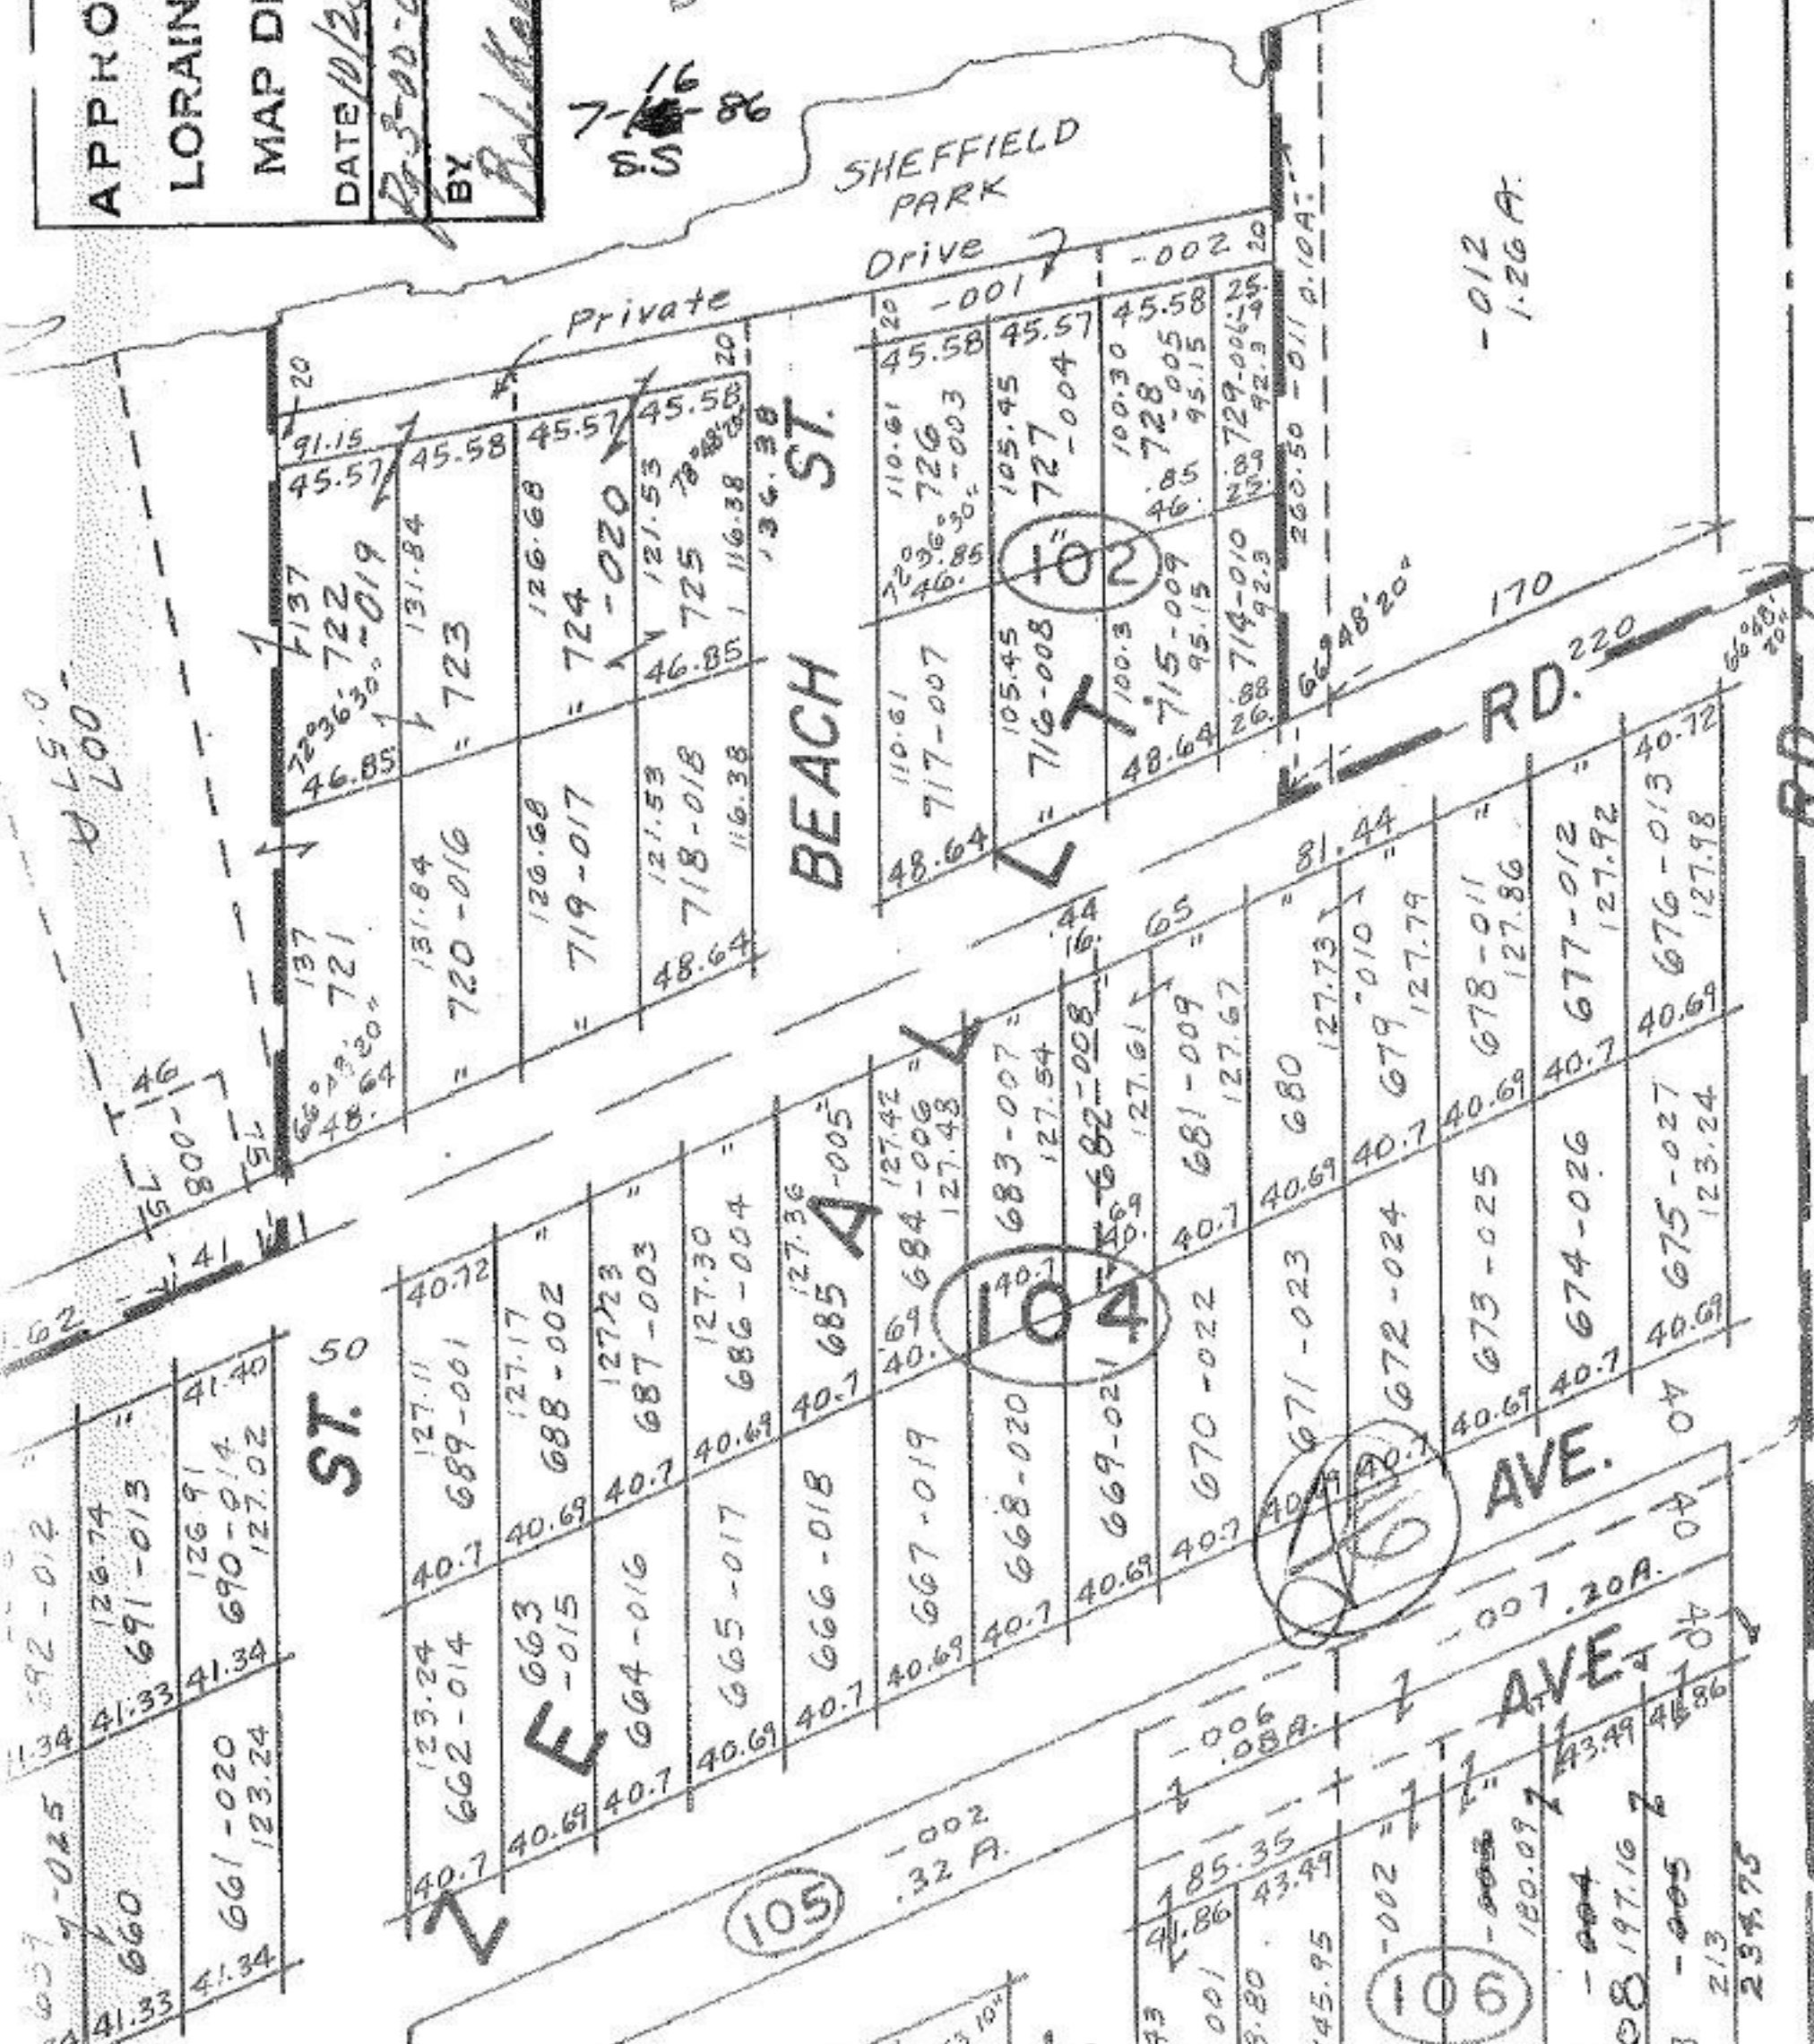

3145

RD. 6 1/2

3145