


17

3156



3156

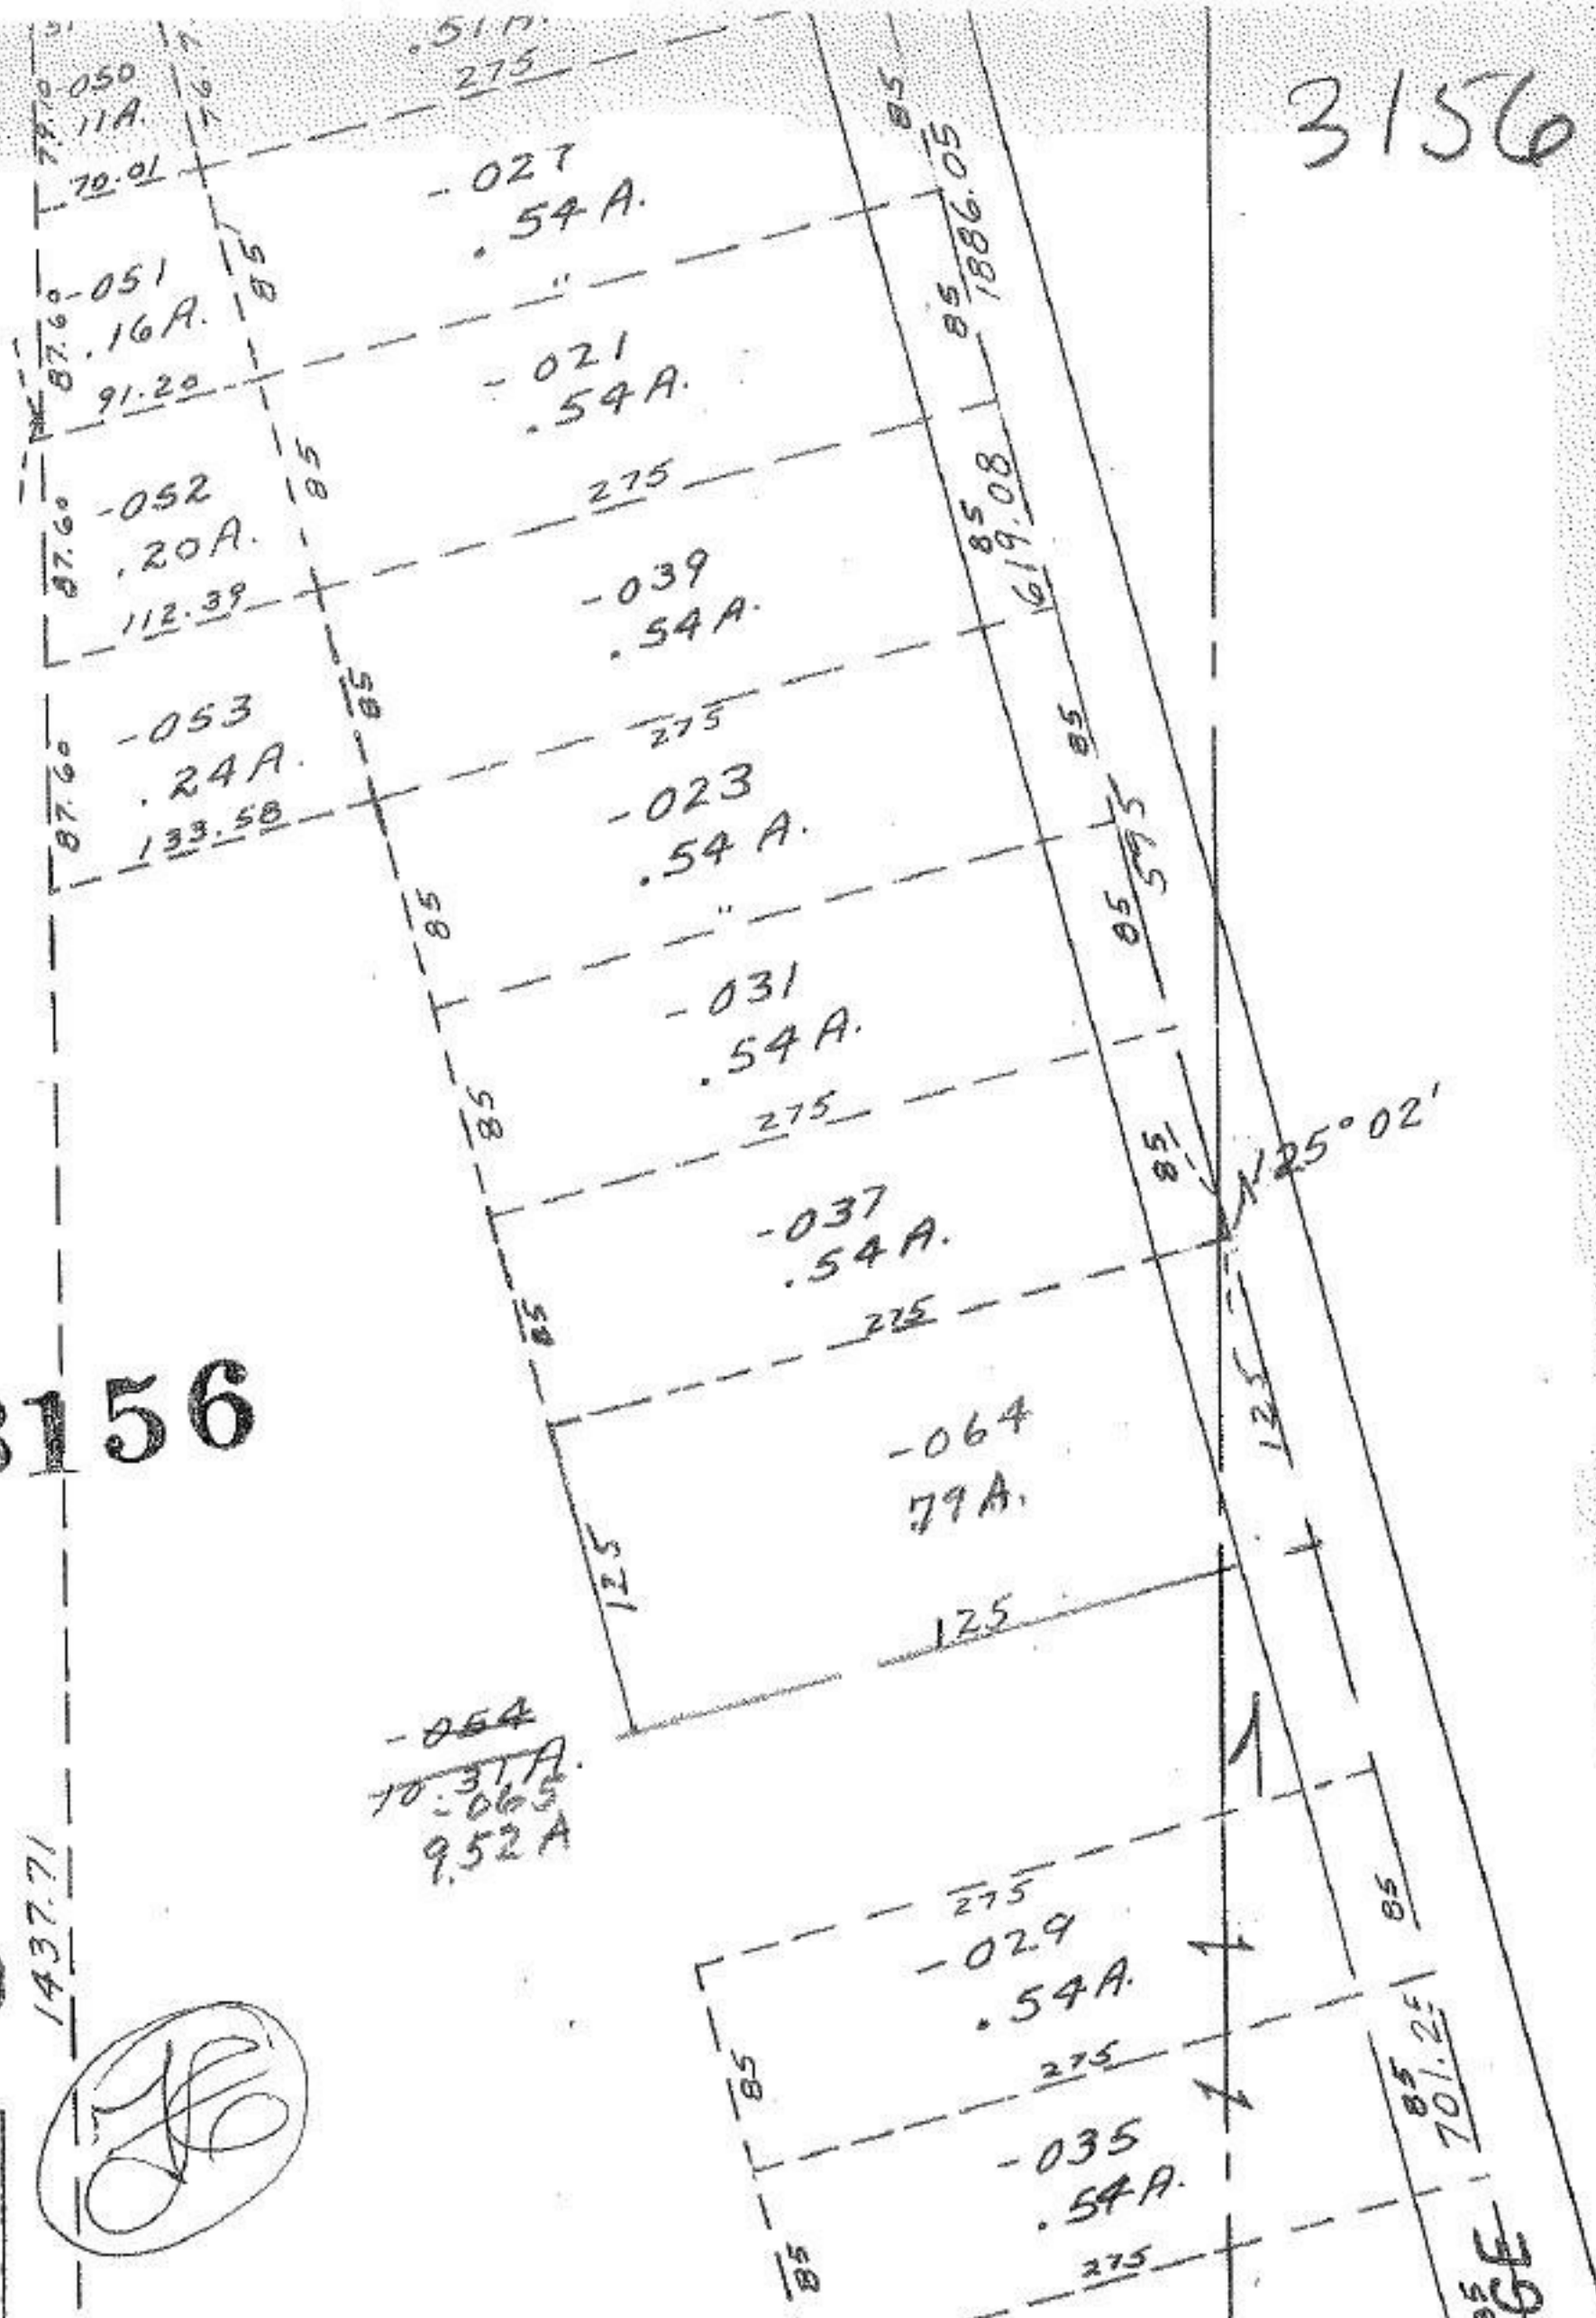

DEC 2 1969

1437.71

(Handwritten signature in a circle)

APPROVED
LORAIN CO.