


3158

WOODFORD AVE.

S.T.

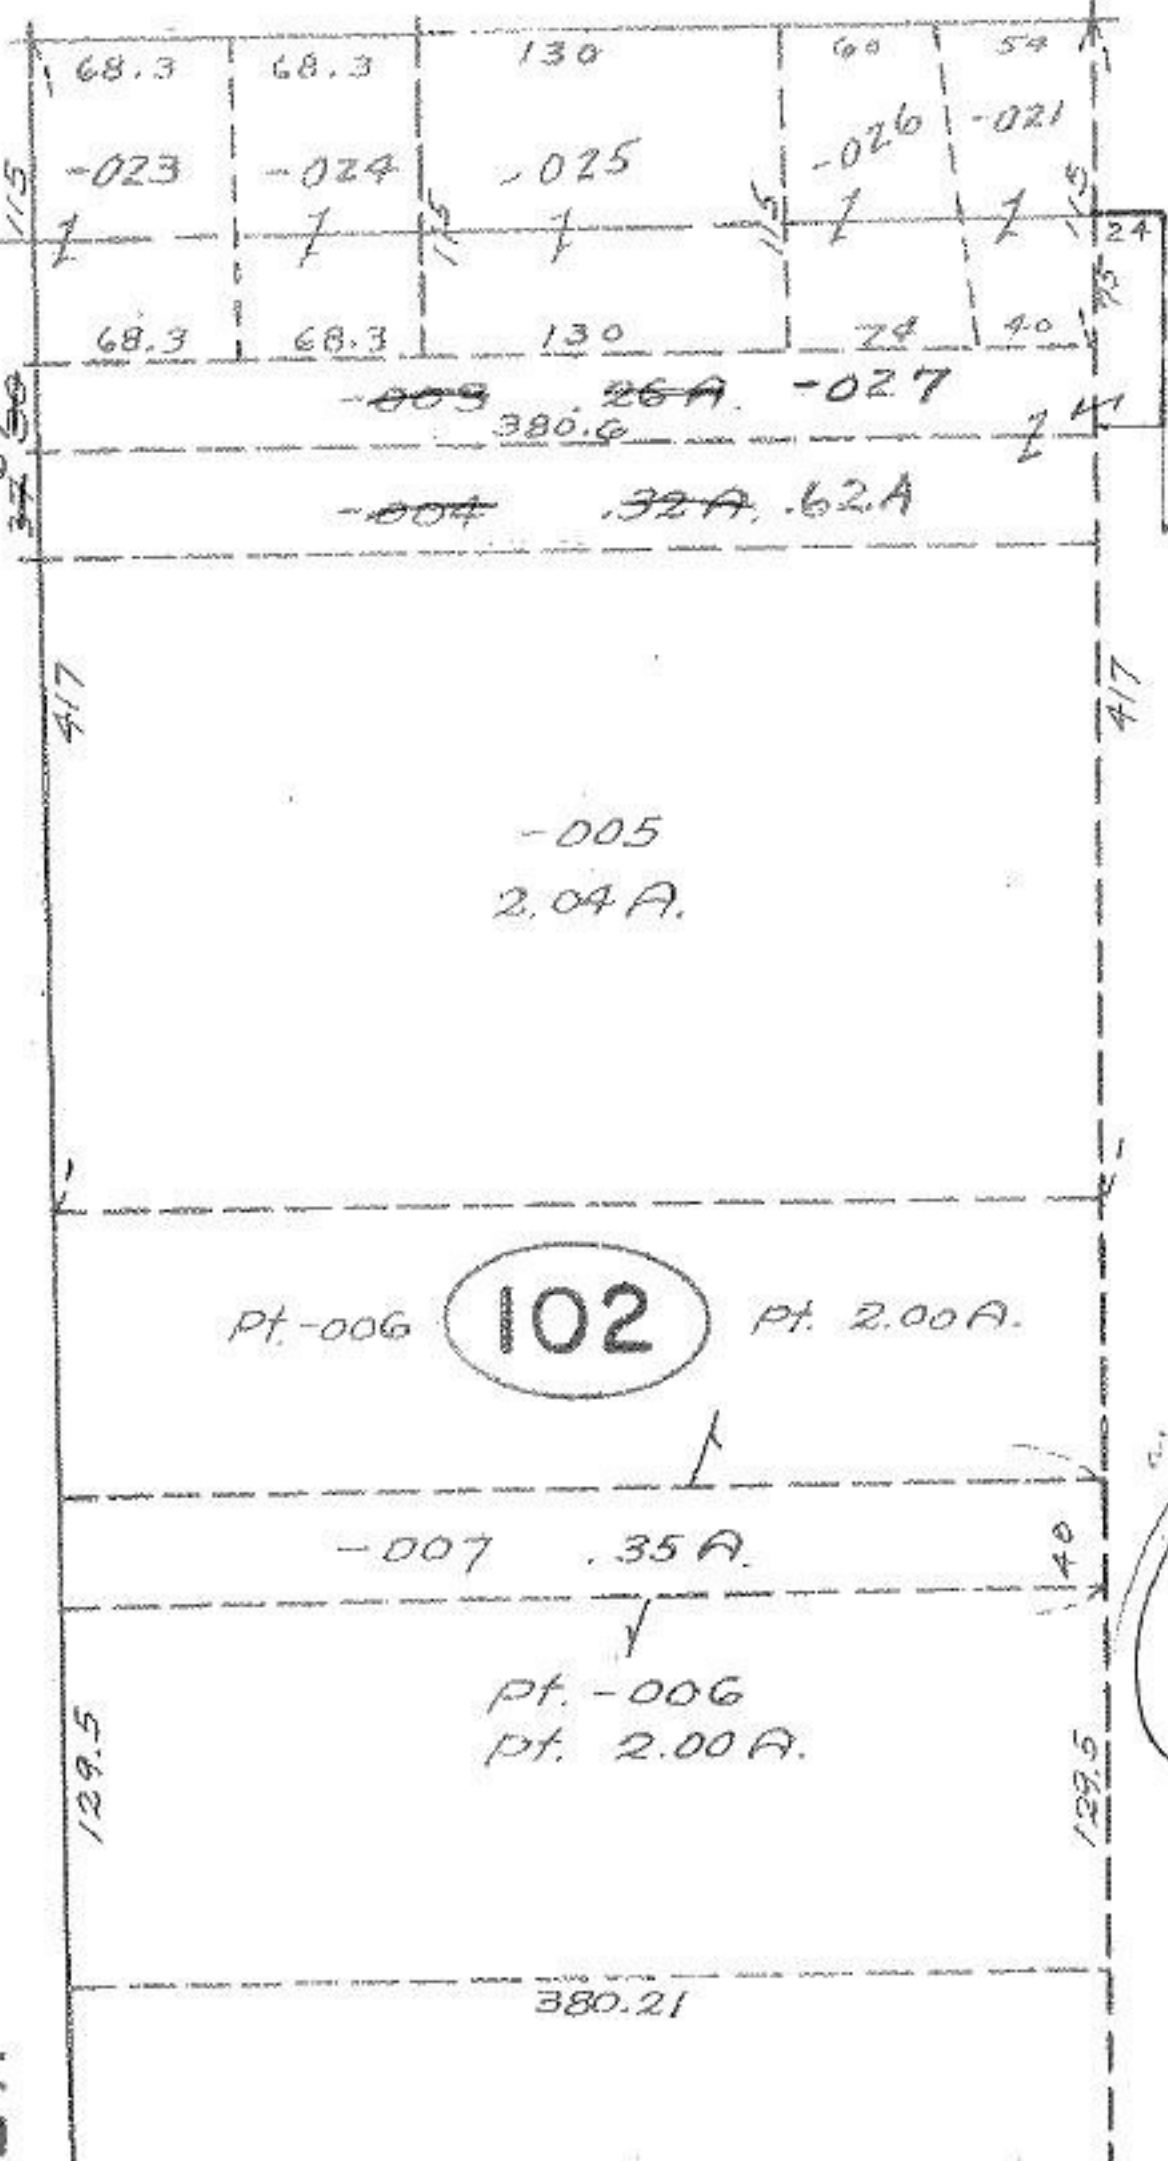

3158

DEC 5 1969

APPROVED  
 LORAIN CO.  
 MAP DEPT.  
 [Signature]