

-002
60.00 A.
60.18 A. D.

-022
57.45 A.


3159

102

3159
DEC 2 1969

APPROVED
LORAIN CO.
MAP DEPT.
DATE 10/31/69
BY
R. V. Kellering

61.79 A.
7-30-5
(Signature)

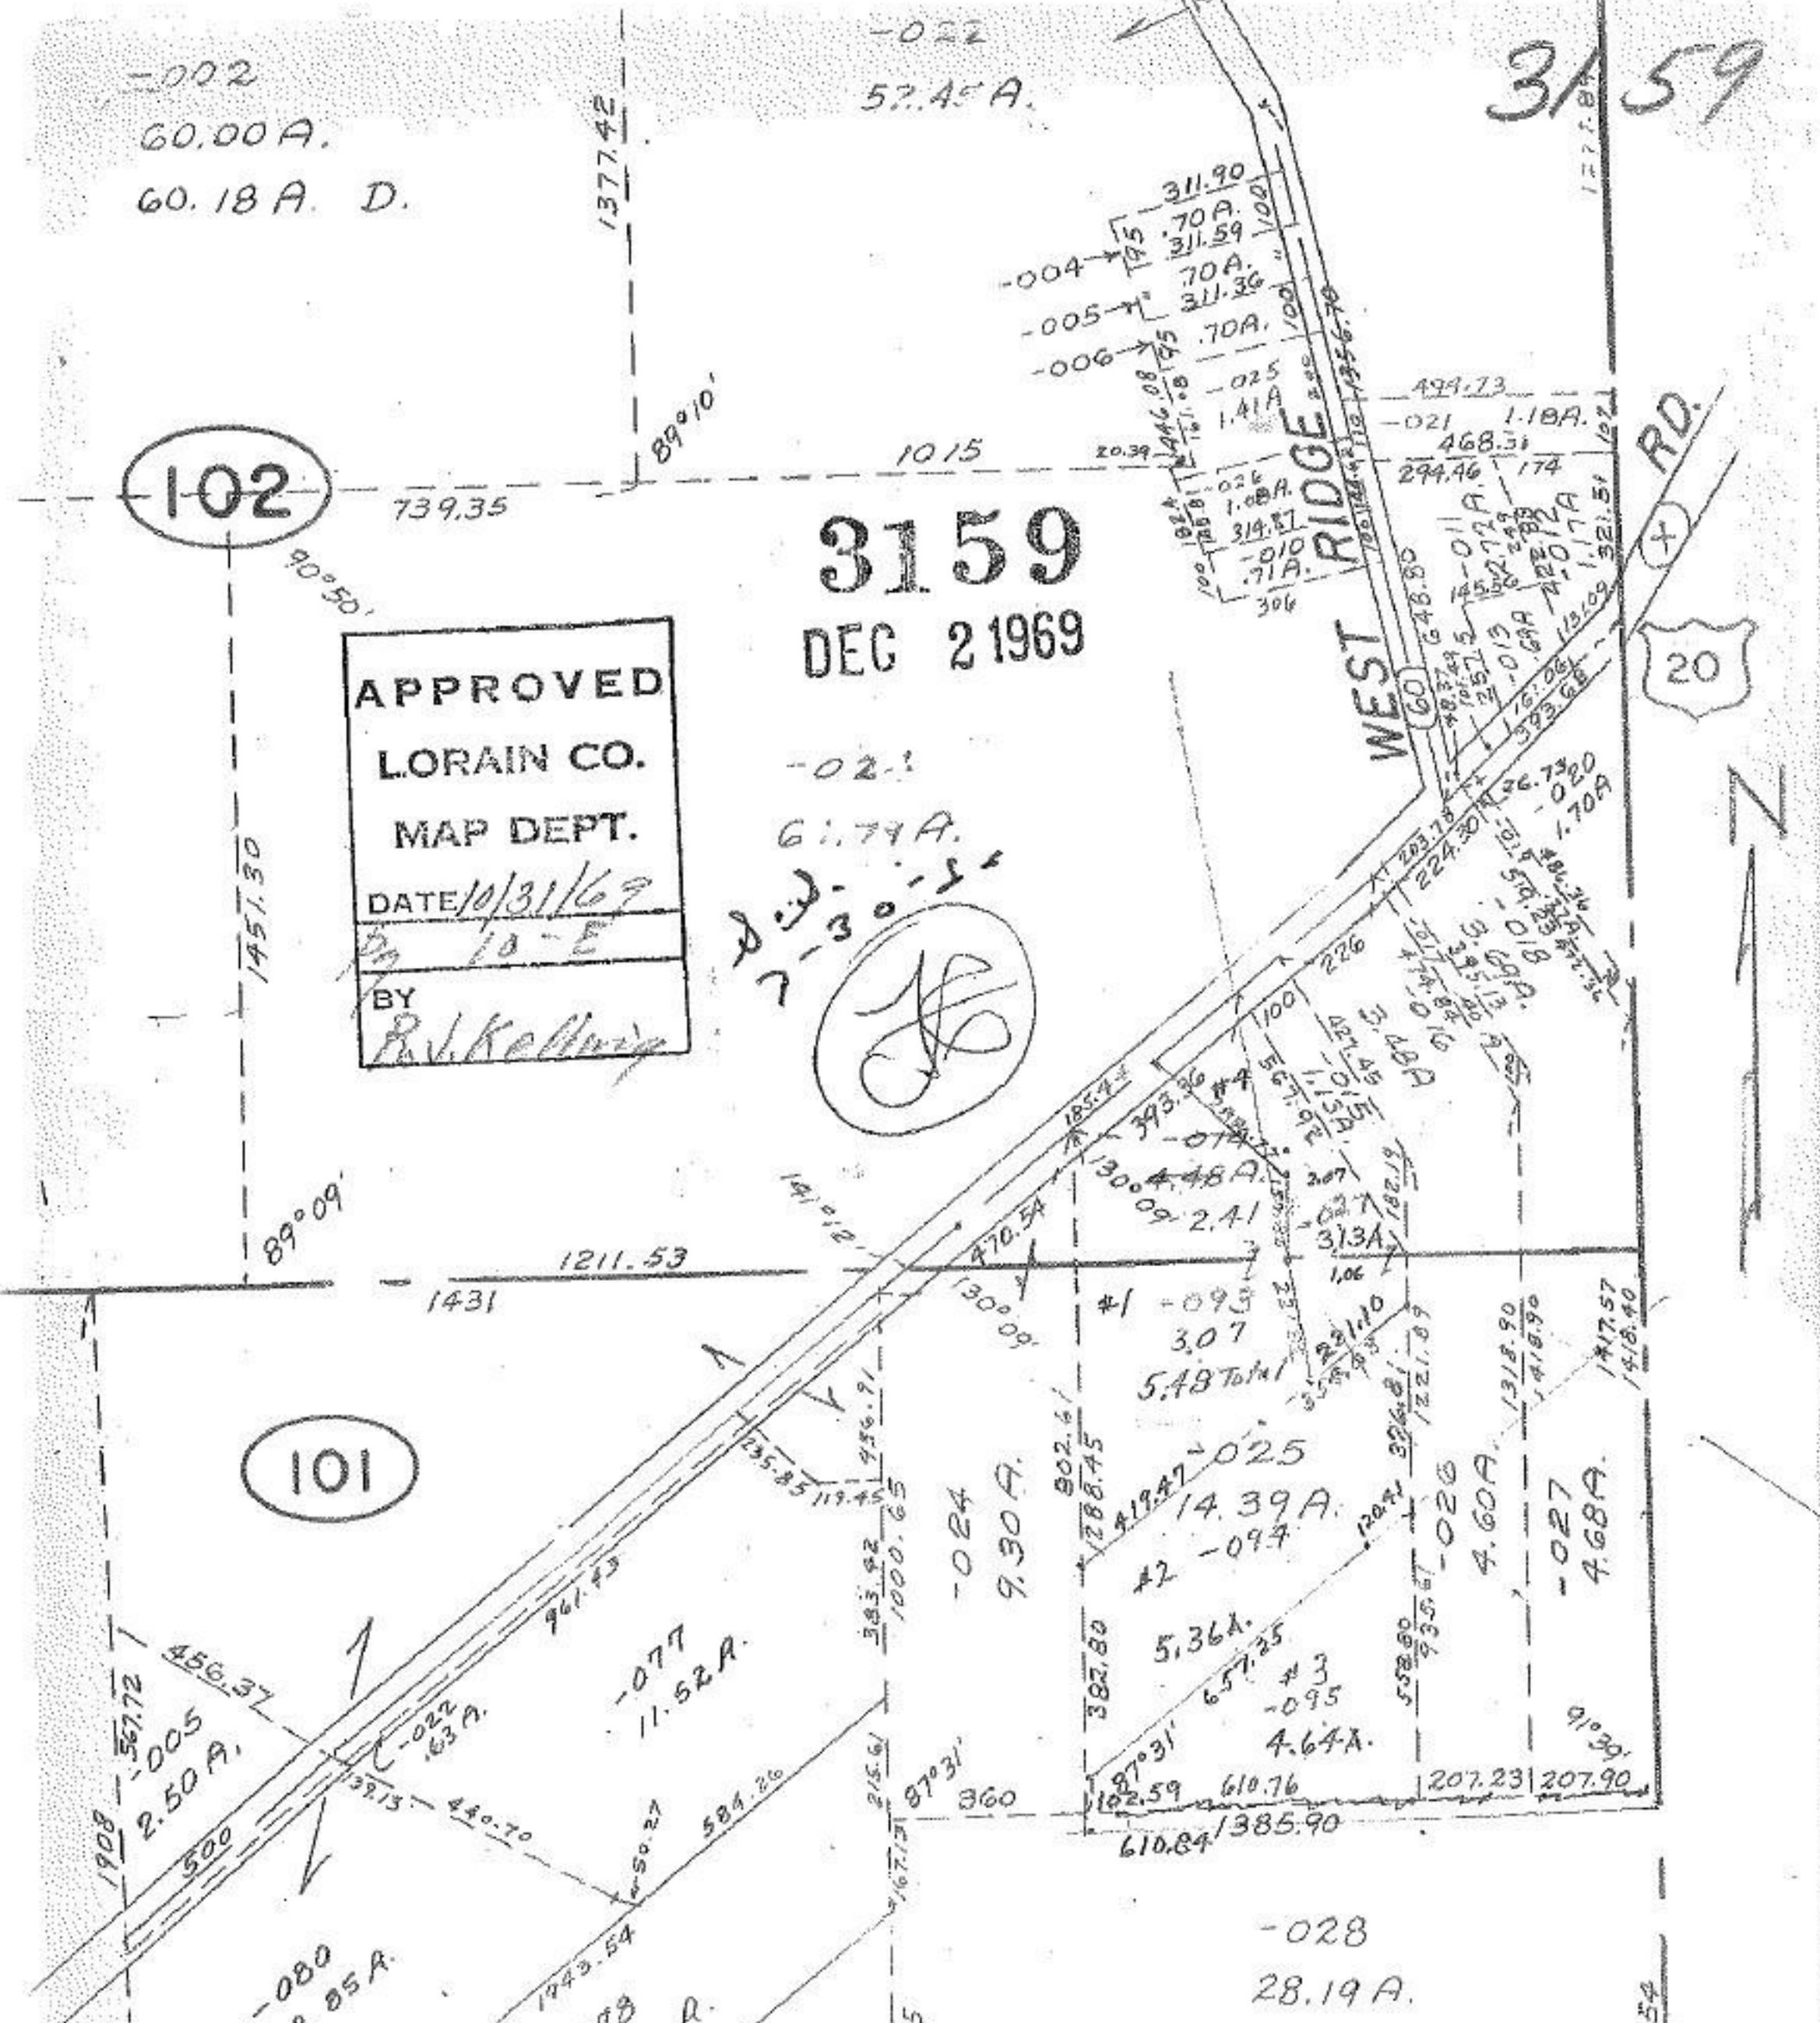

20

101

-028
28.19 A.

54