

Pt 03-00-058-101-040
Pt 39.48 A.

-001
6.795 A.

500

N. Y. C.

-002 9.5 A.
-003 10.0 A.

-001 10.00 A.

-015
-015
34.43 A.
34.27 A.

003
2.68 A.

-011
11.90 A.

-002 13.00 A.
-003 13.19 A.

2436.87

60

-004 46.93 A.

-005 2.97 A.

-006 21.84 A.

7074
297
355.19
-011 7.14 A.

660.07
-013 7.14 A.

197.34
199.26
190 A.
423.86


1346.02

1603.97
-012

APPROVED
LORAIN CO.
MAP DEPT.
DATE 1/3/69
BY
R. L. Kelling

DEC 2 1969

3166

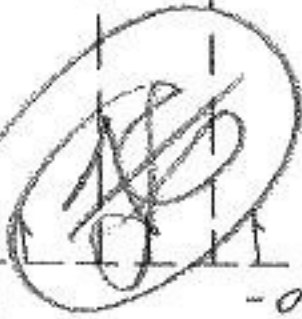

1315.38
128.63
-003
-004
-005
-006
-007
-008
128.63
219.5

833.54

642.97

1095 117
69 119
307

480
154.2 153.4 153.7

572.73
141.3 1329

8900

