


3182

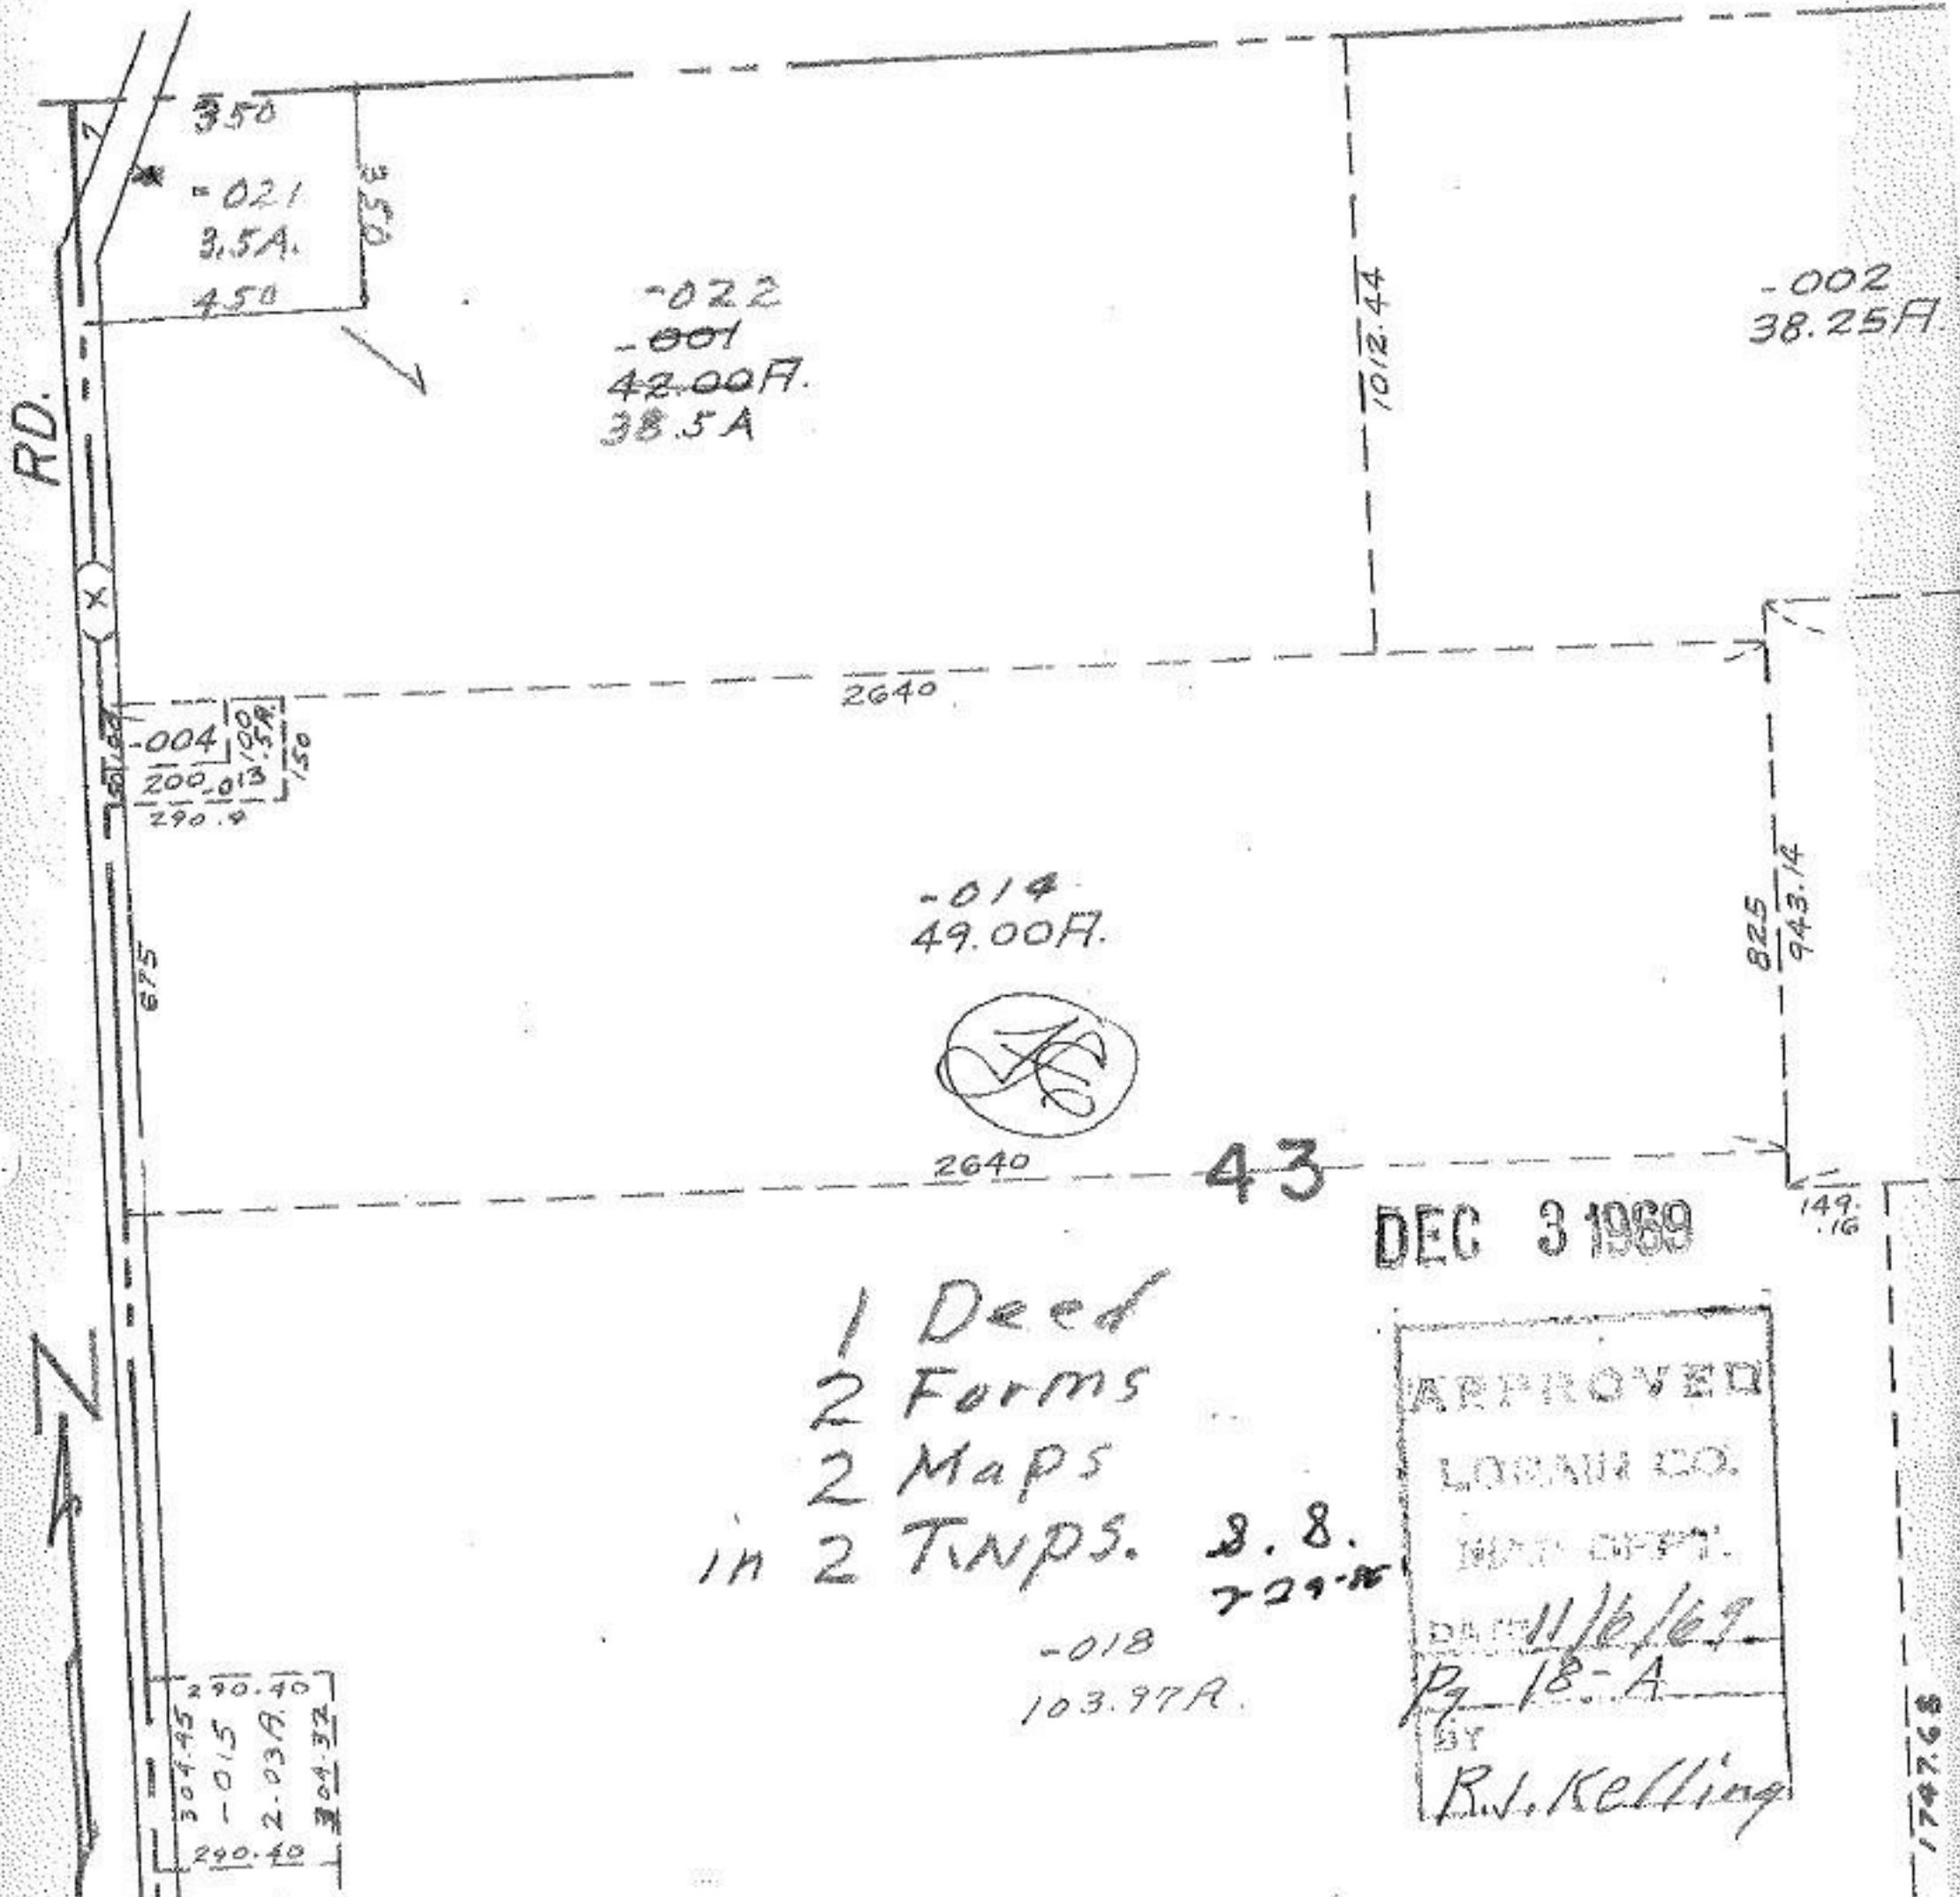

3182