

4-00-019c

DEC 2 1969 3187


#3187  
3188

3188

3187

APPROVED  
 LORAIN CO.  
 MAP DEPT.  
 DATE 11/12/69  
 4-00-019-C  
 BY  
 R. J. Kellum

9-16-86 L.L.

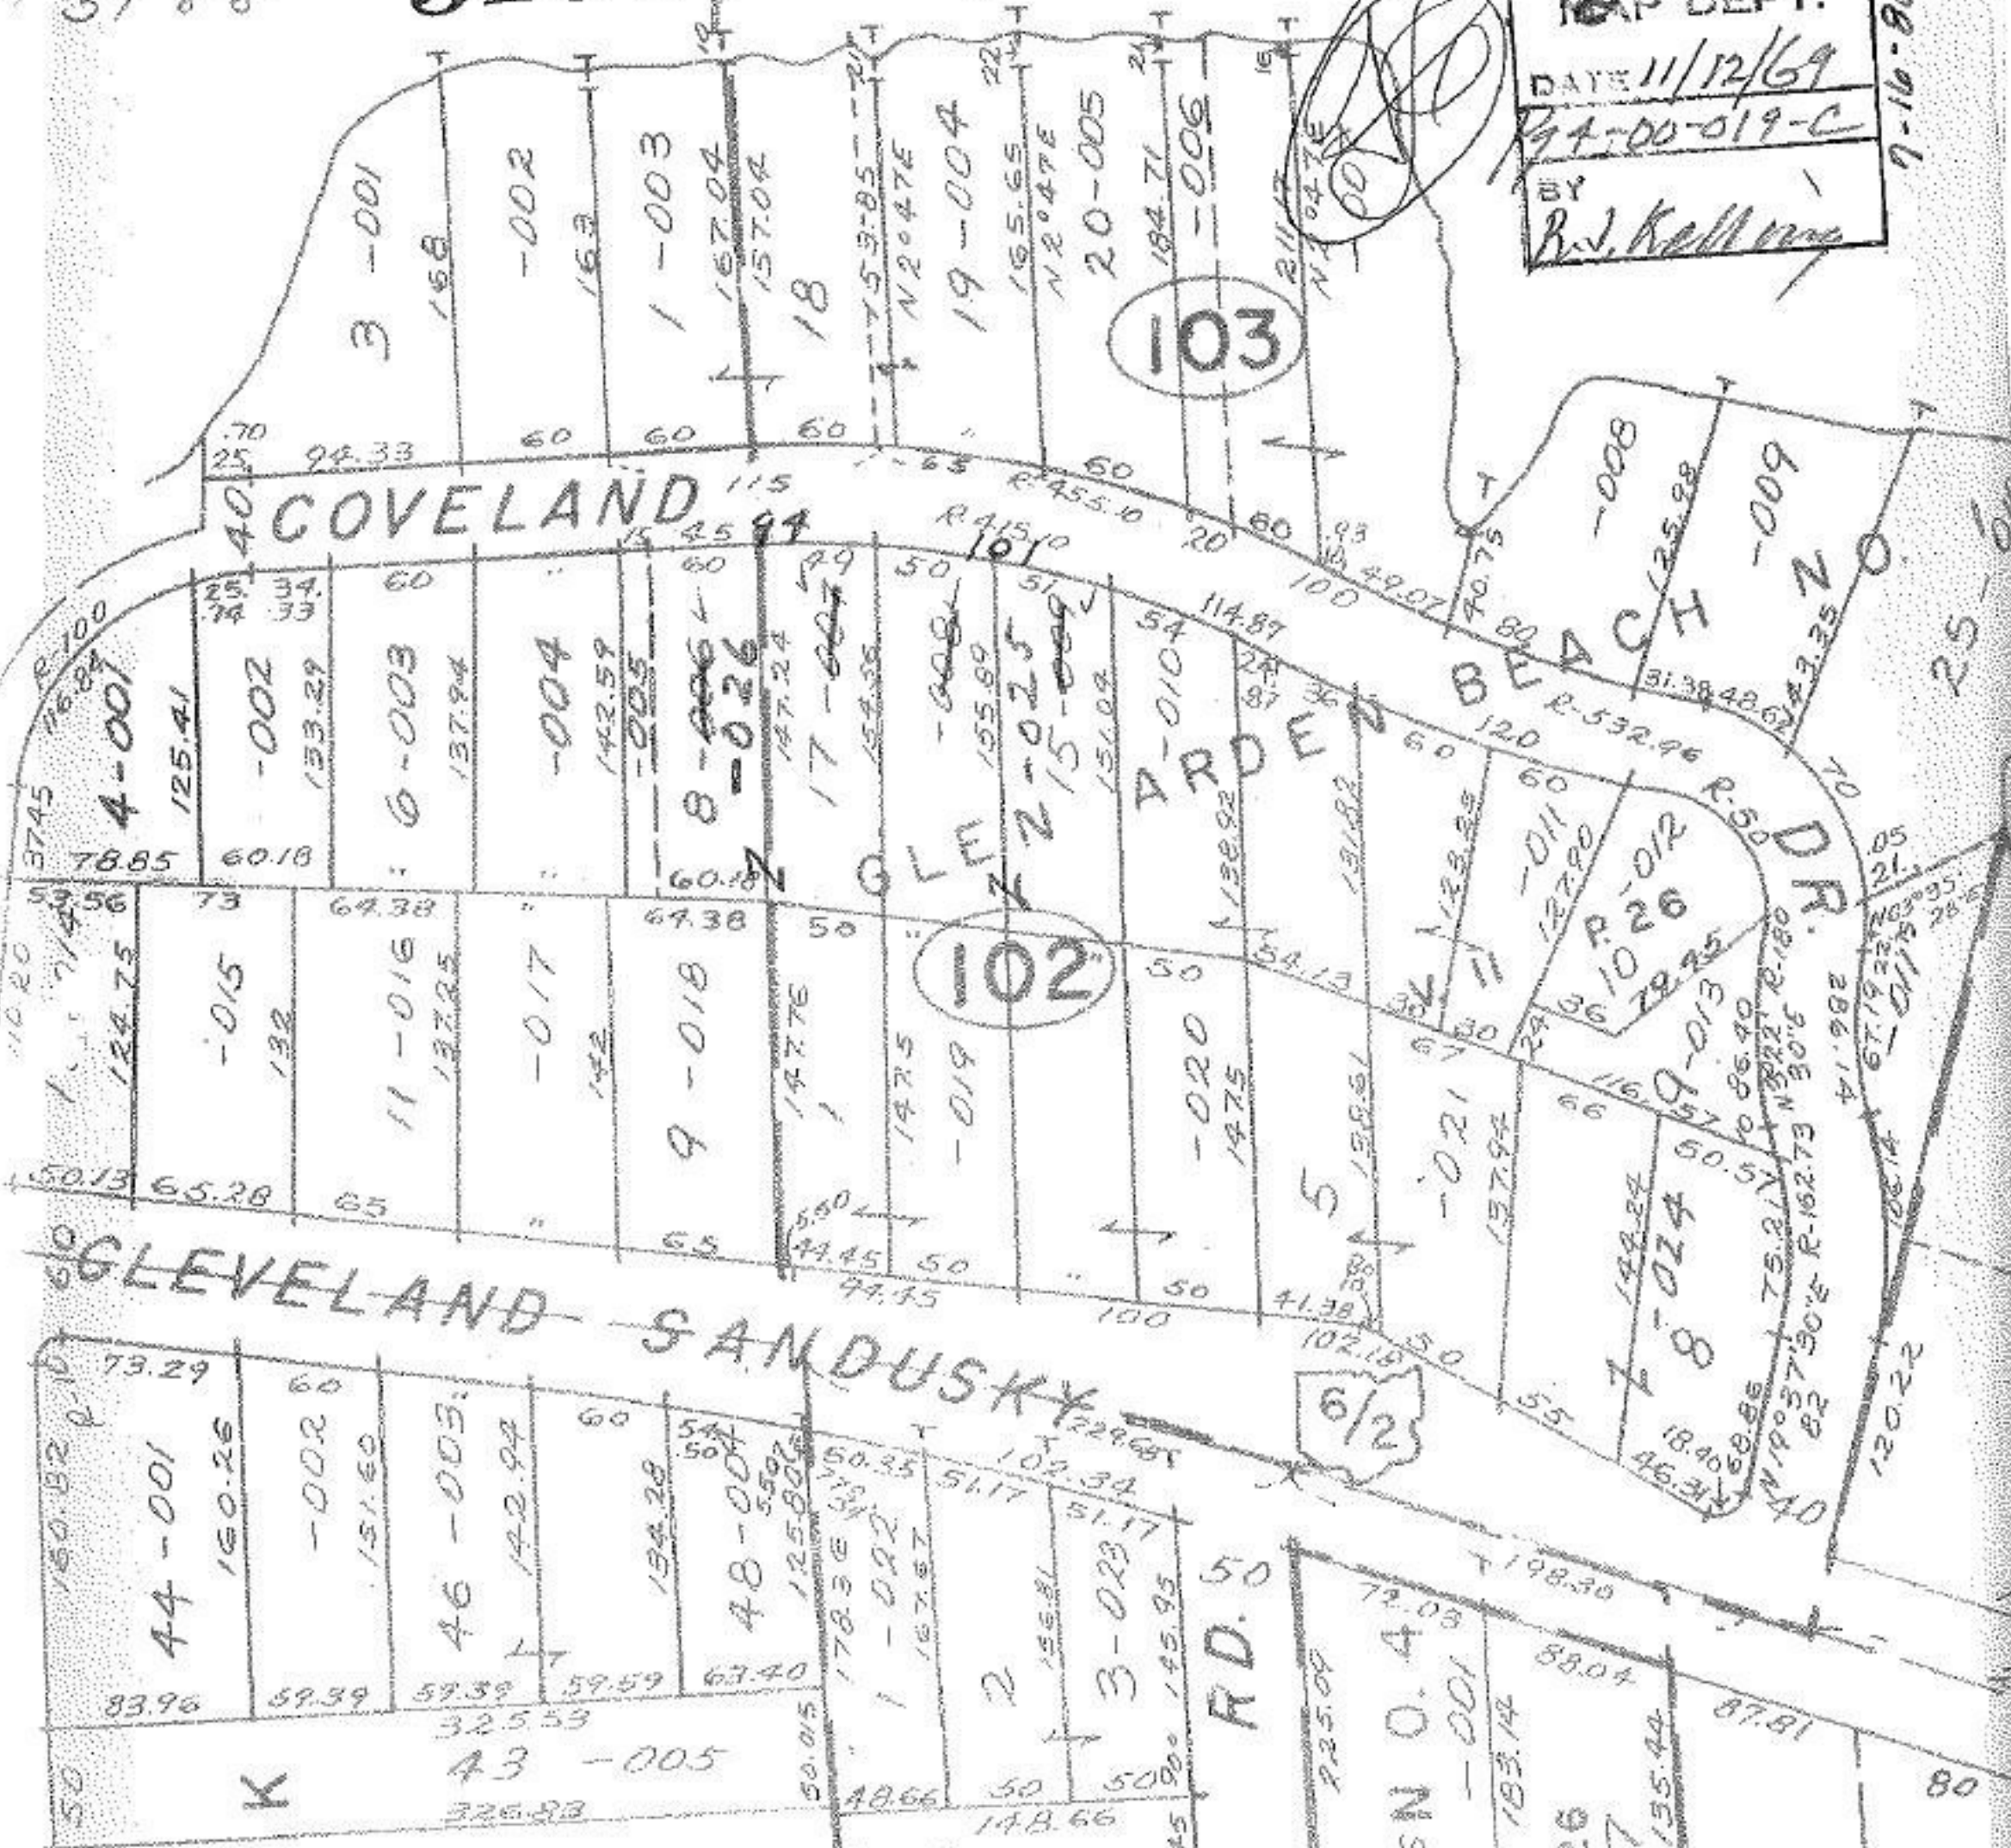

COVELAND

BLANCH

GLEVELAND SANDUSKY

RD. 50

RD. 40

K

6/2

103

102

3-001

-002

-003

157.04

157.04

18

159.85

19-004

155.65

20-005

184.71

-006

211.17

N 04 7 E

100

4-001

125.41

-002

133.29

6-003

137.94

-004

142.59

-005

8-006

147.24

-026

147.24

17-008

154.38

155.89

2-025

151.09

2-010

114.87

2-010

118.82

118.82

11-016

137.25

-017

142

9-018

147.76

147.5

-019

147.5

147.5

44-001

150.26

-002

151.60

46-003

142.94

194.28

48-004

125.80

178.36

-022

167.87

2

155.81

3-023

145.95

RD. 50

225.09

6N 0.4

-001

183.14

26

135.44

87.81

80

198.30

88.04

198.30

198.30

198.30

198.30