
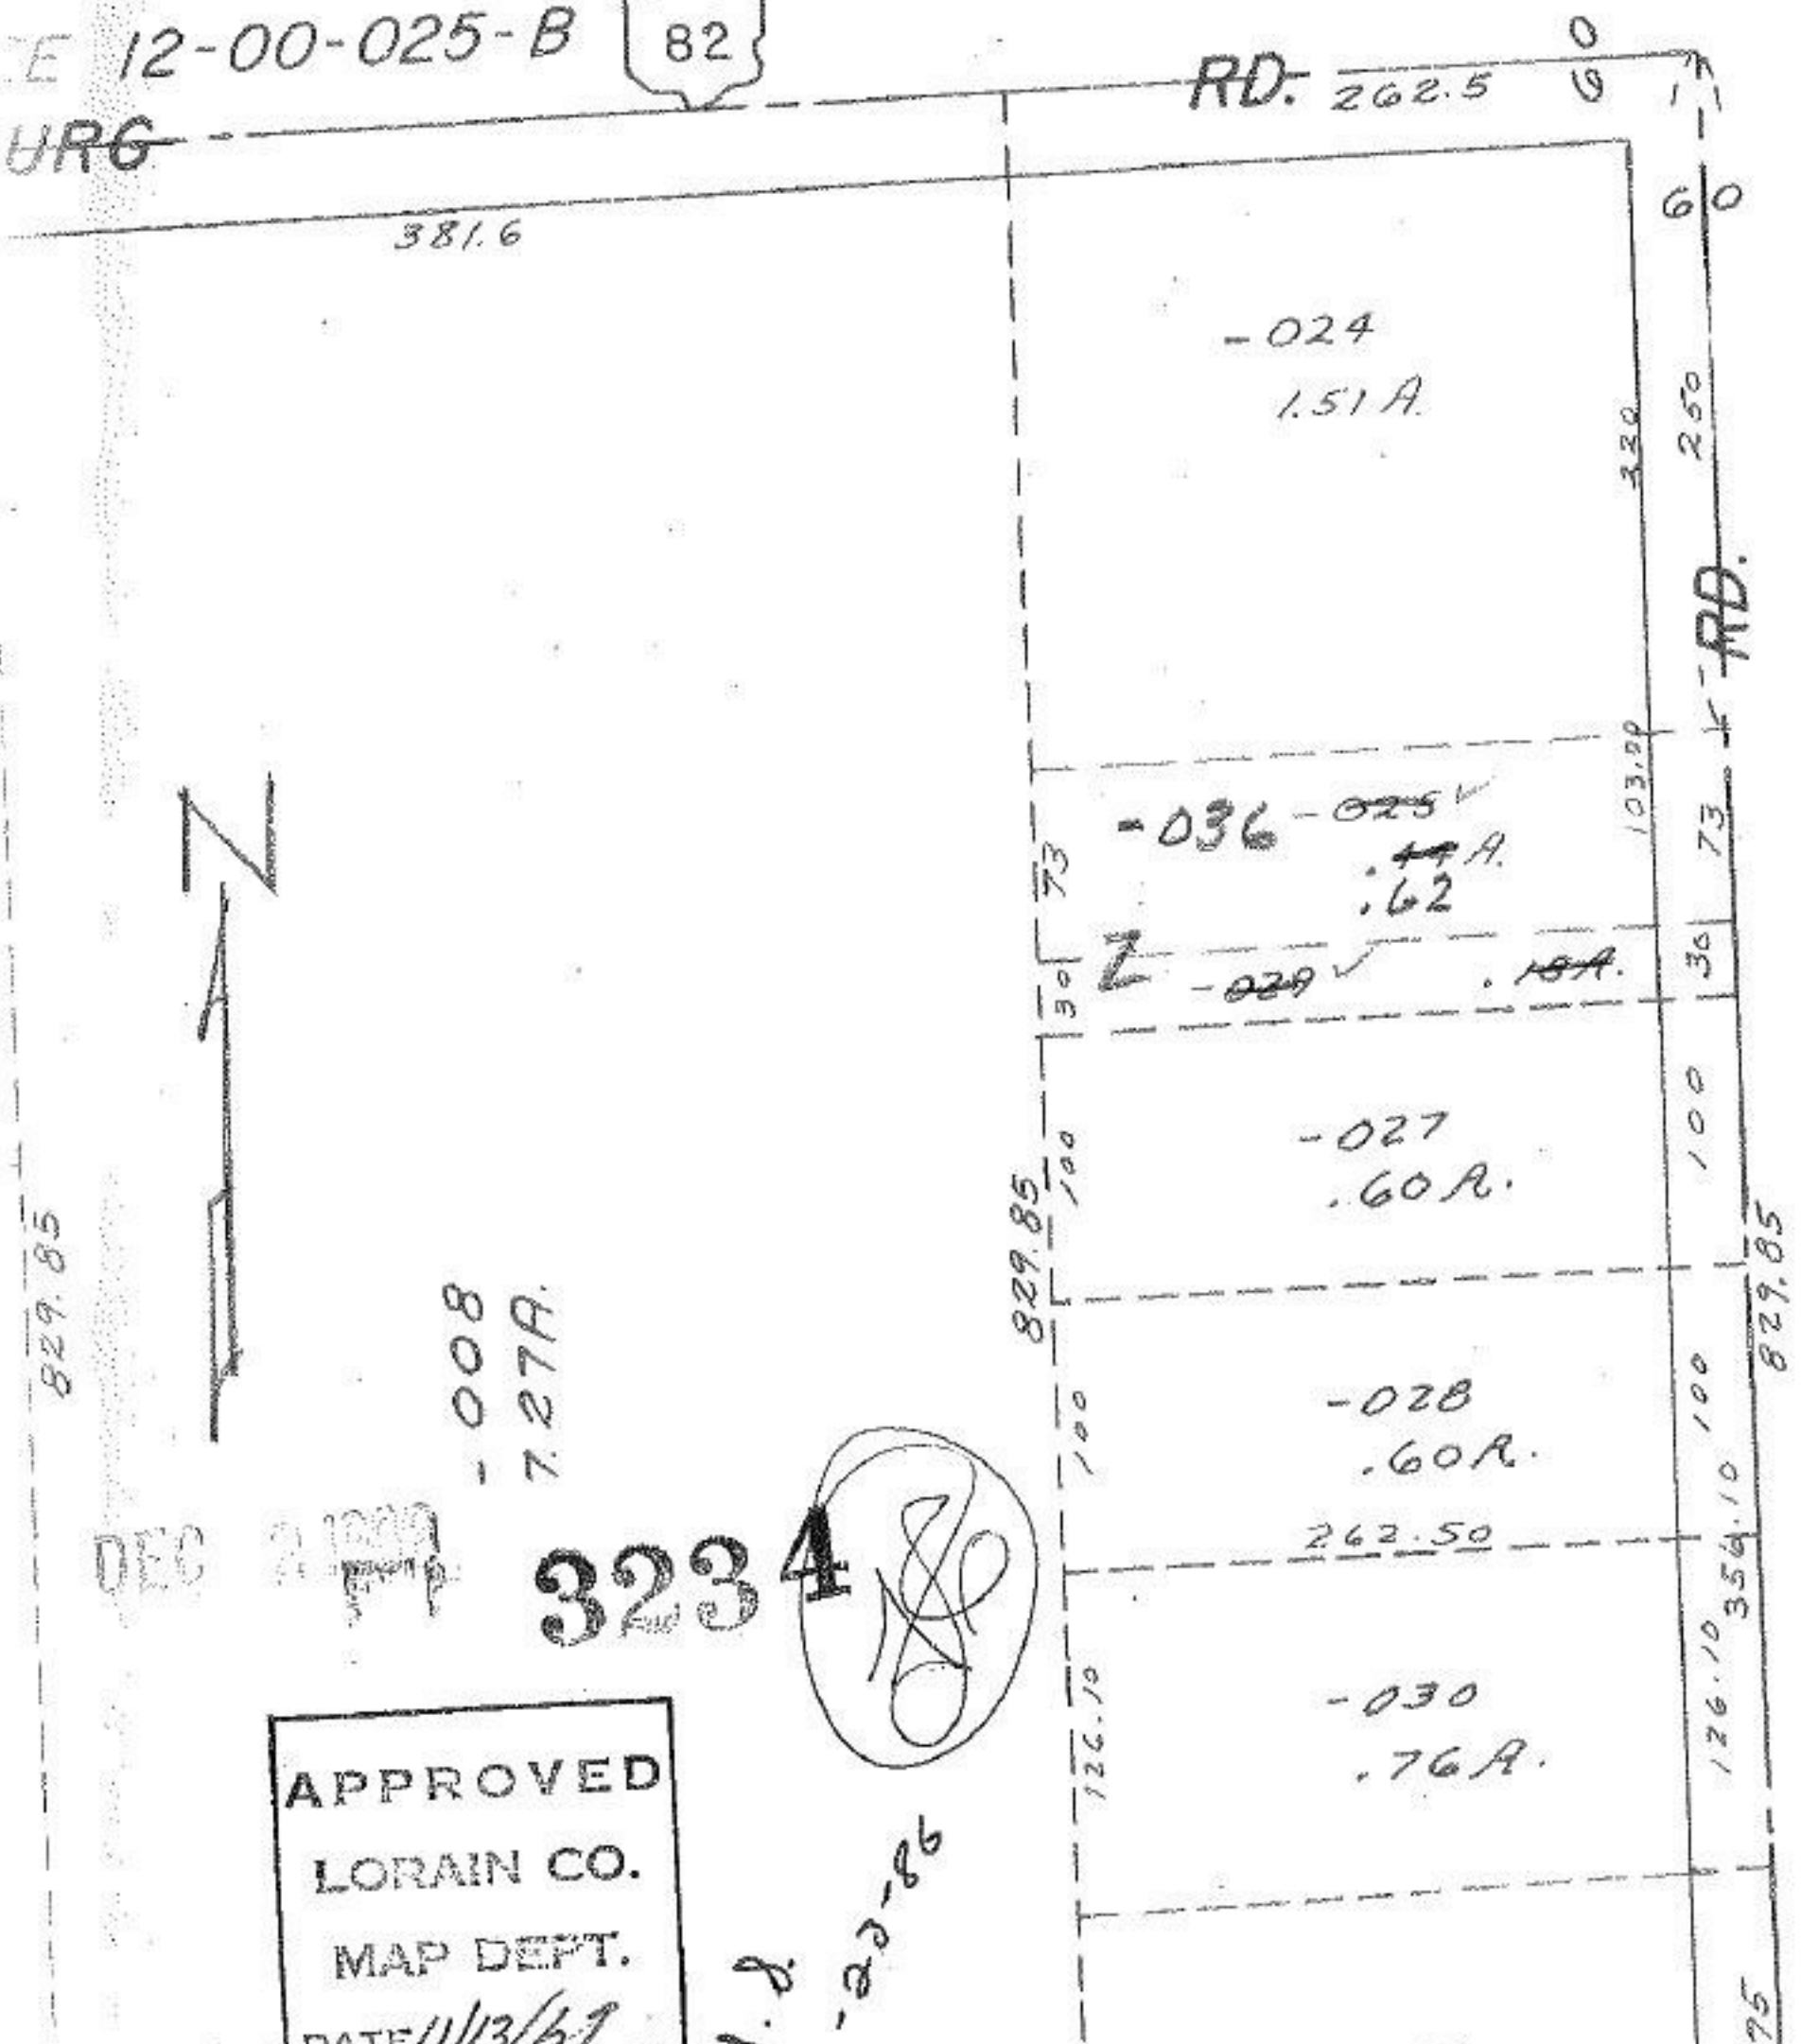


#3234

12-00-026B

E 12-00-025-B 

URG



APPROVED
 LORAIN CO.
 MAP DEPT.
 DATE 11/13/67

3234 

J. D. - 2-2-86

829.85

-008
 7.27A.

DEC

21000