



SEE 9-00-079-A

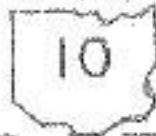

3307

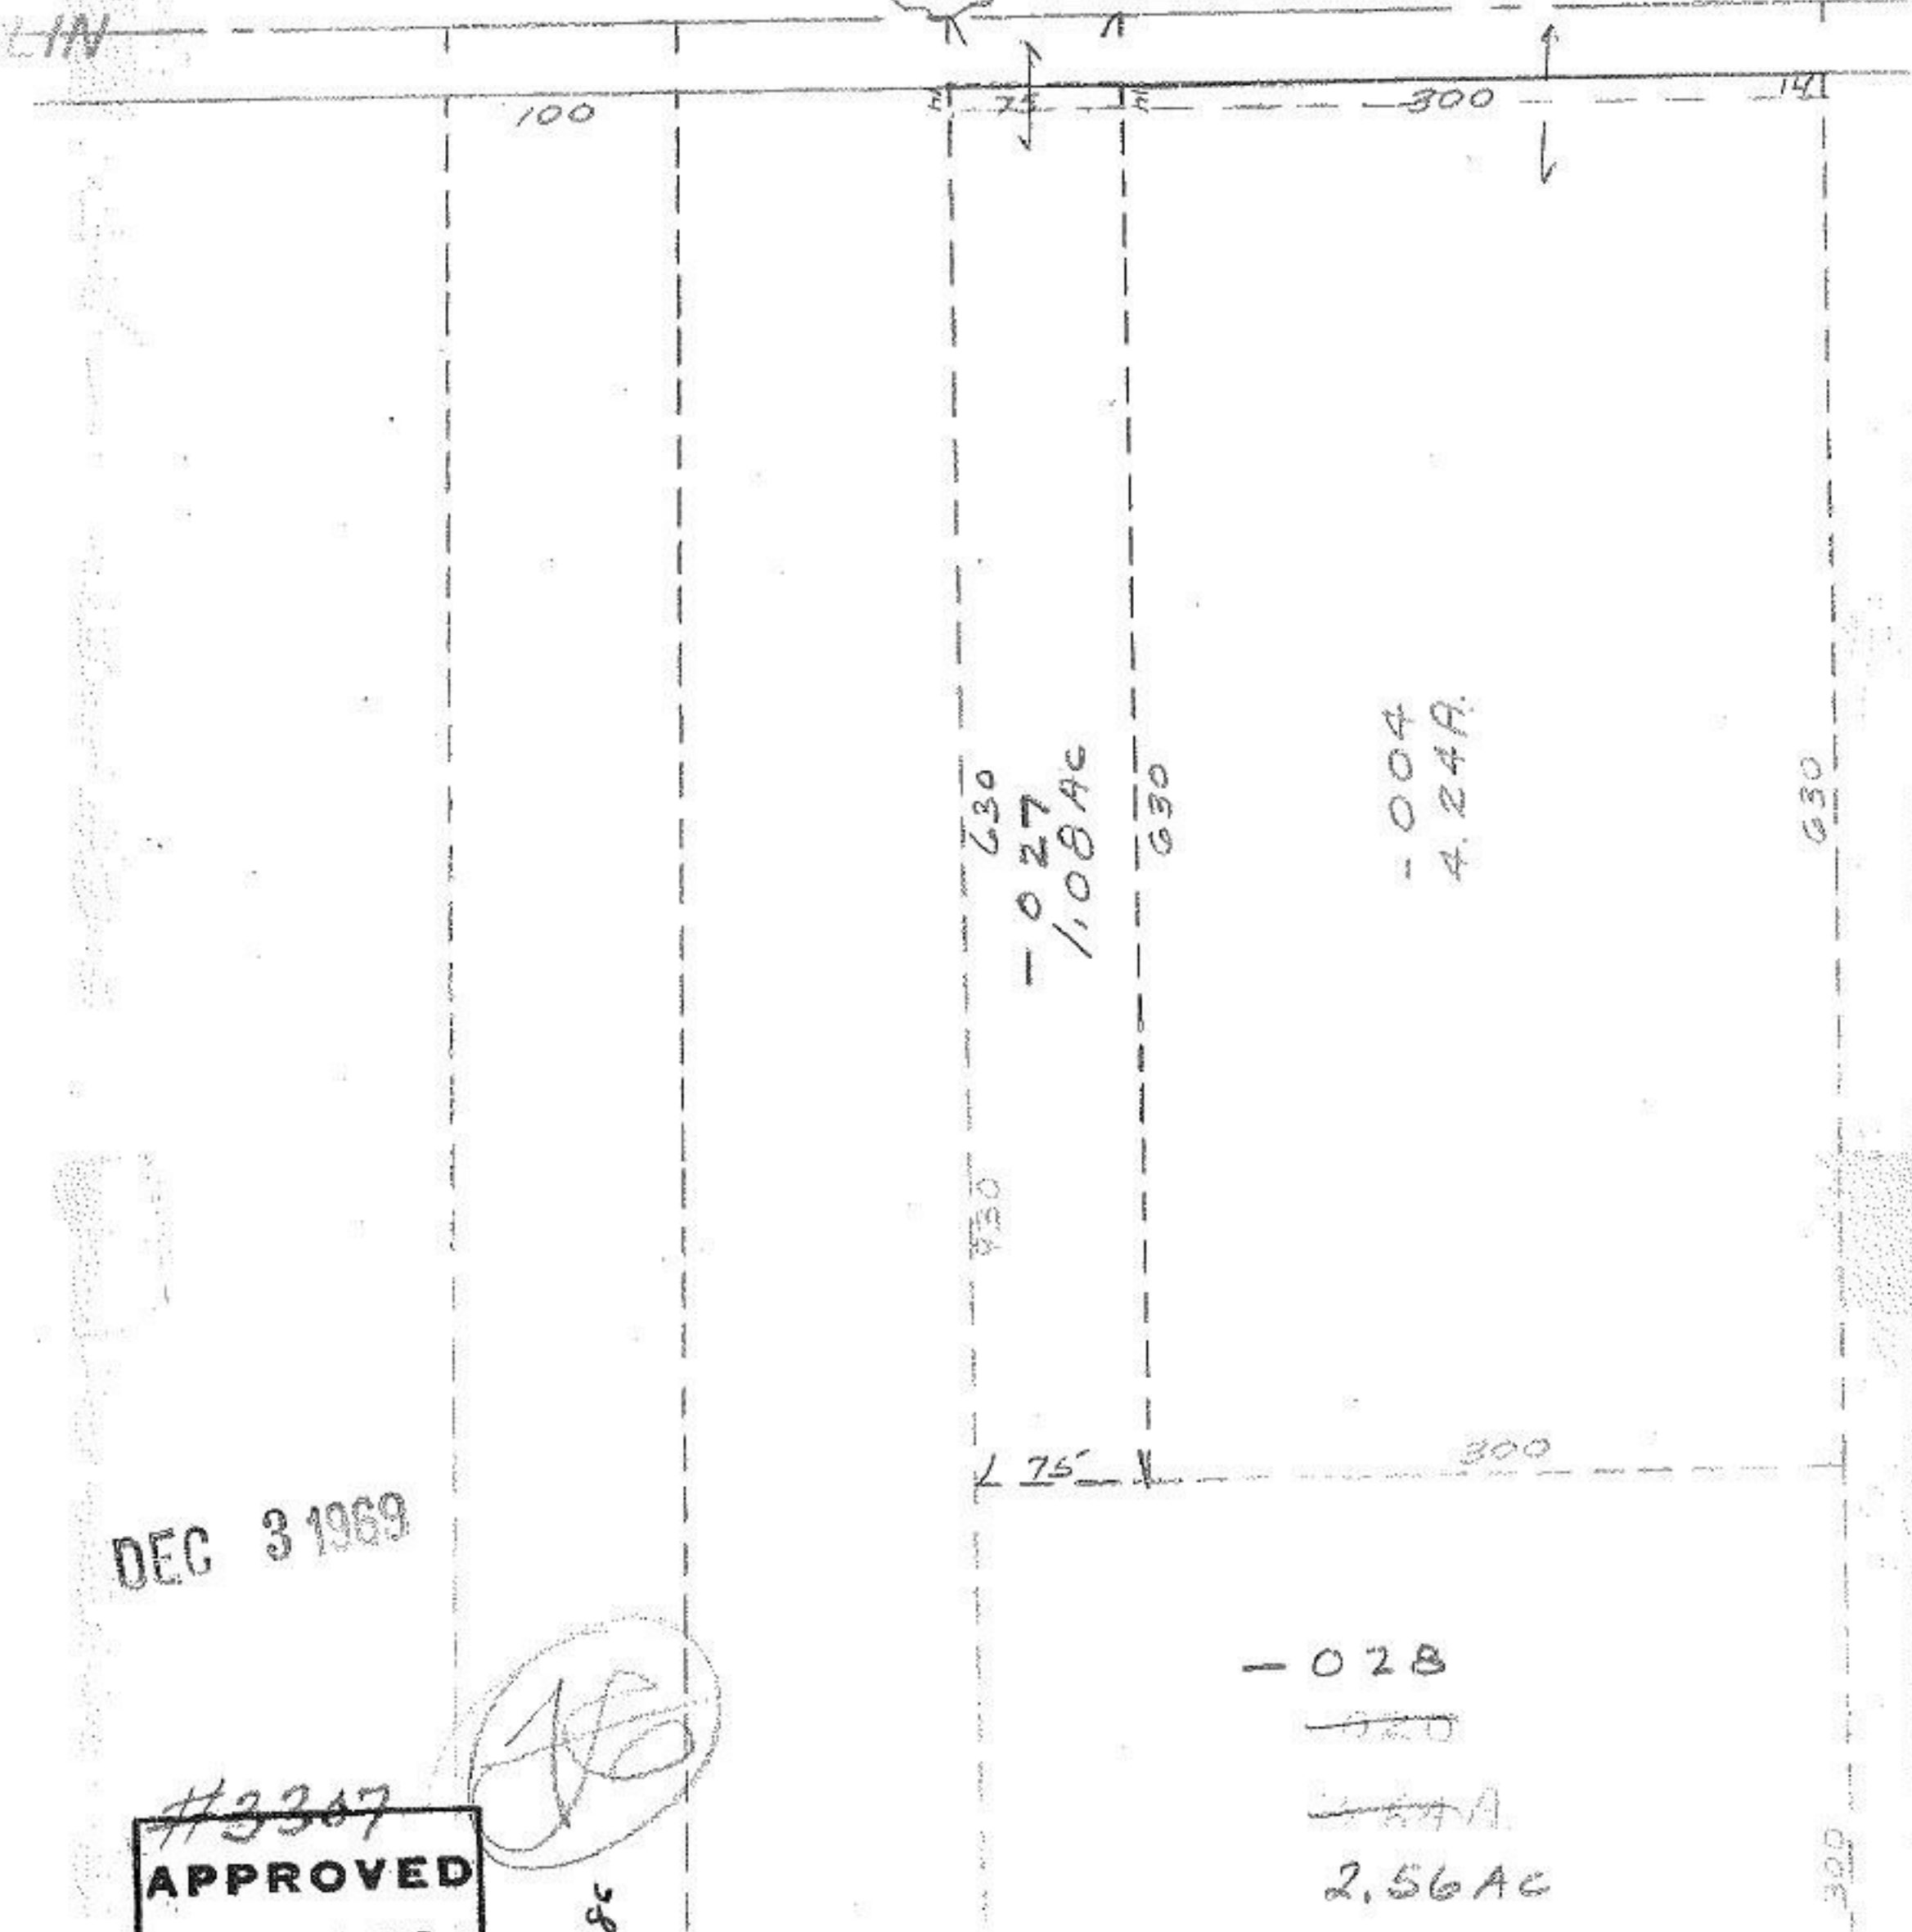

DEC 3 1969



#3307  
**APPROVED**  
**LORAIN CO.**

1-8c

- 0.28  
~~0.20~~  
~~4.24 A.~~  
 2.56 AC

630

300