
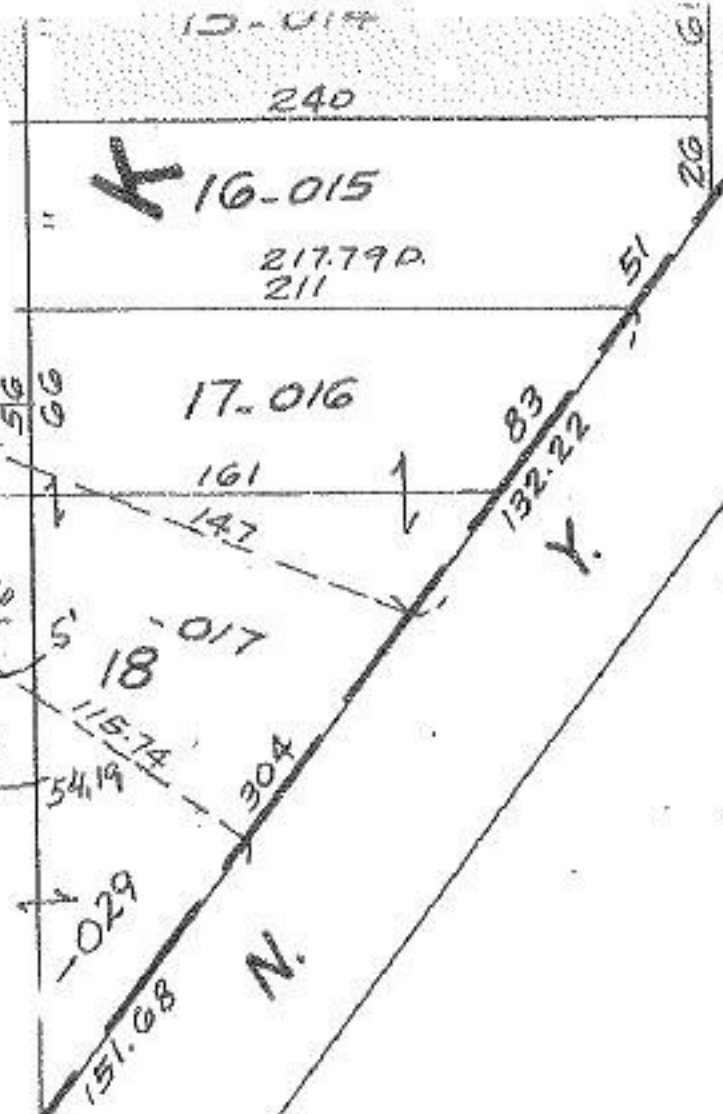


#3316

3316

P99-00-086B
-087-A

KING

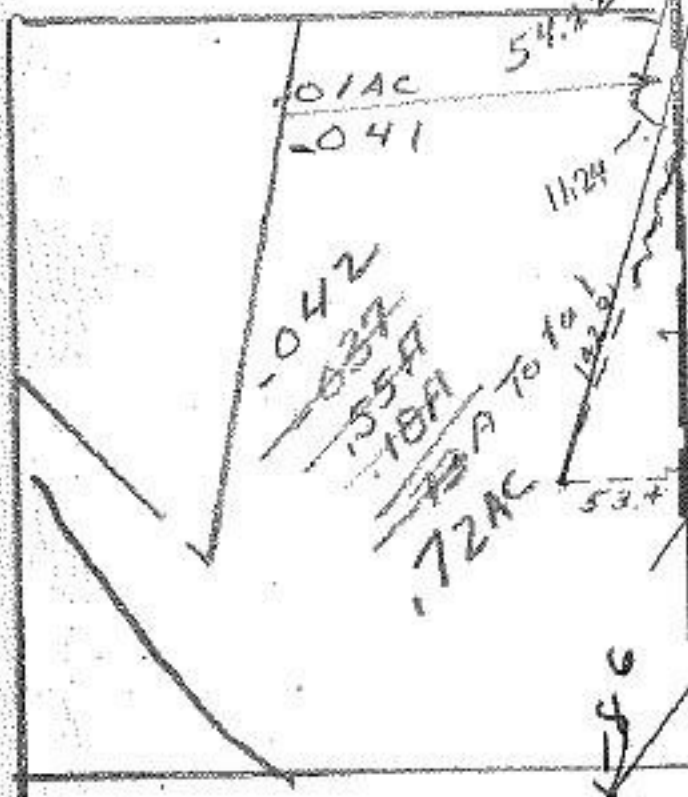

-001
11.50 FT.

S.A.
7-24-68



JAN 5 1969

7-15-68

678.48