


3319

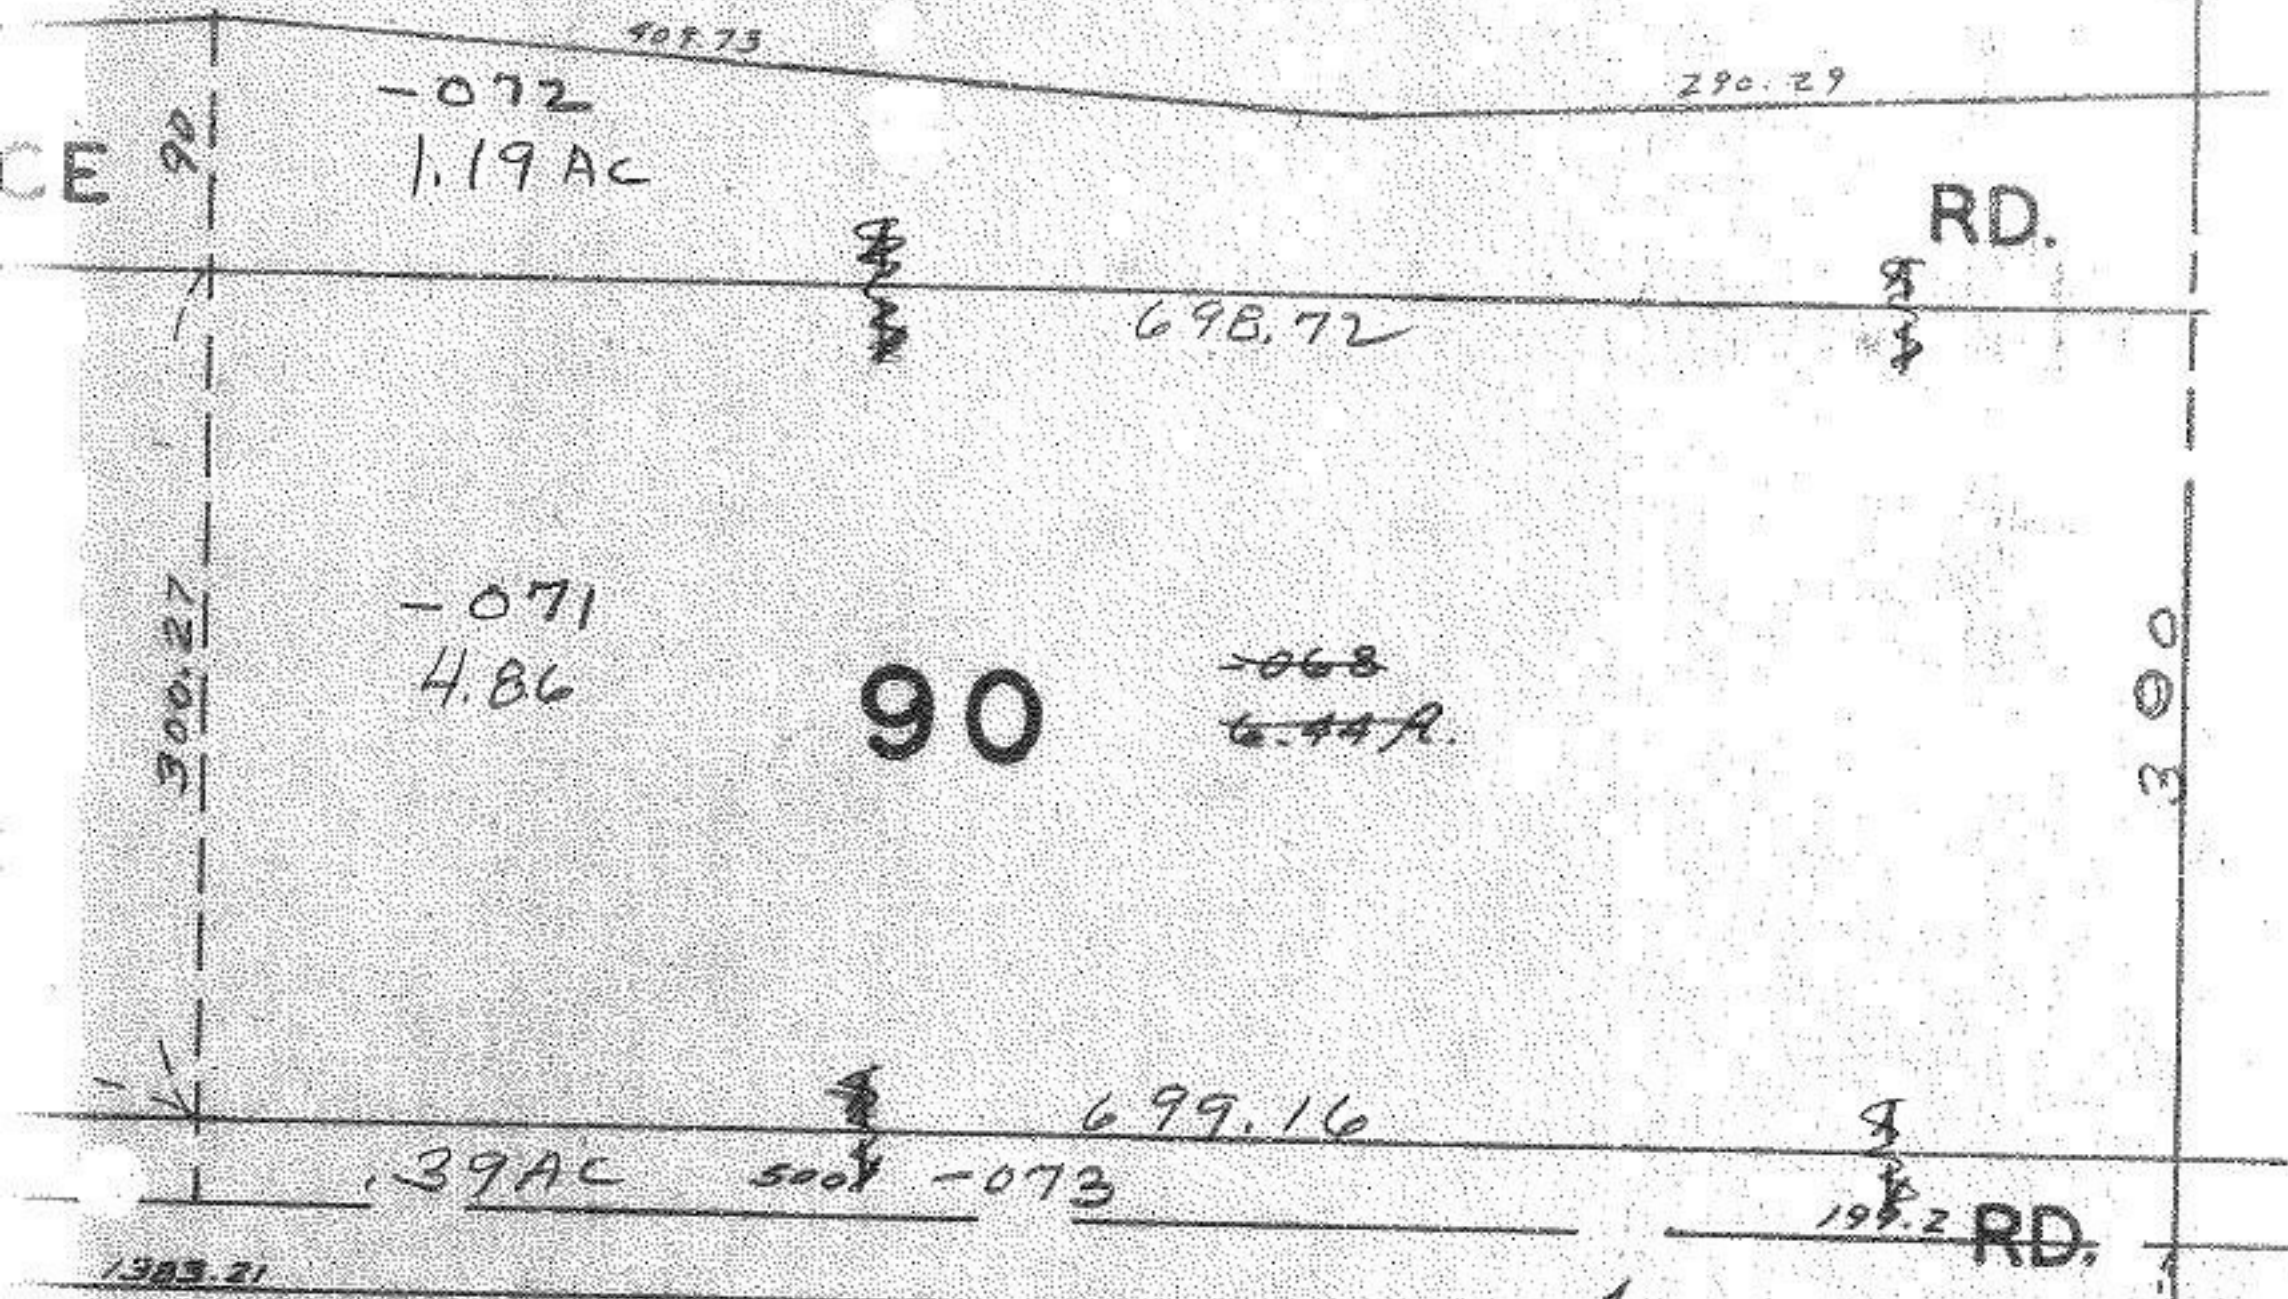

90

~~668~~  
644 ft.

JAN 6 ENT'D

#3319  
 APPROVED  
 LORAIN CO.



VAHOGA COUNTY