


3339

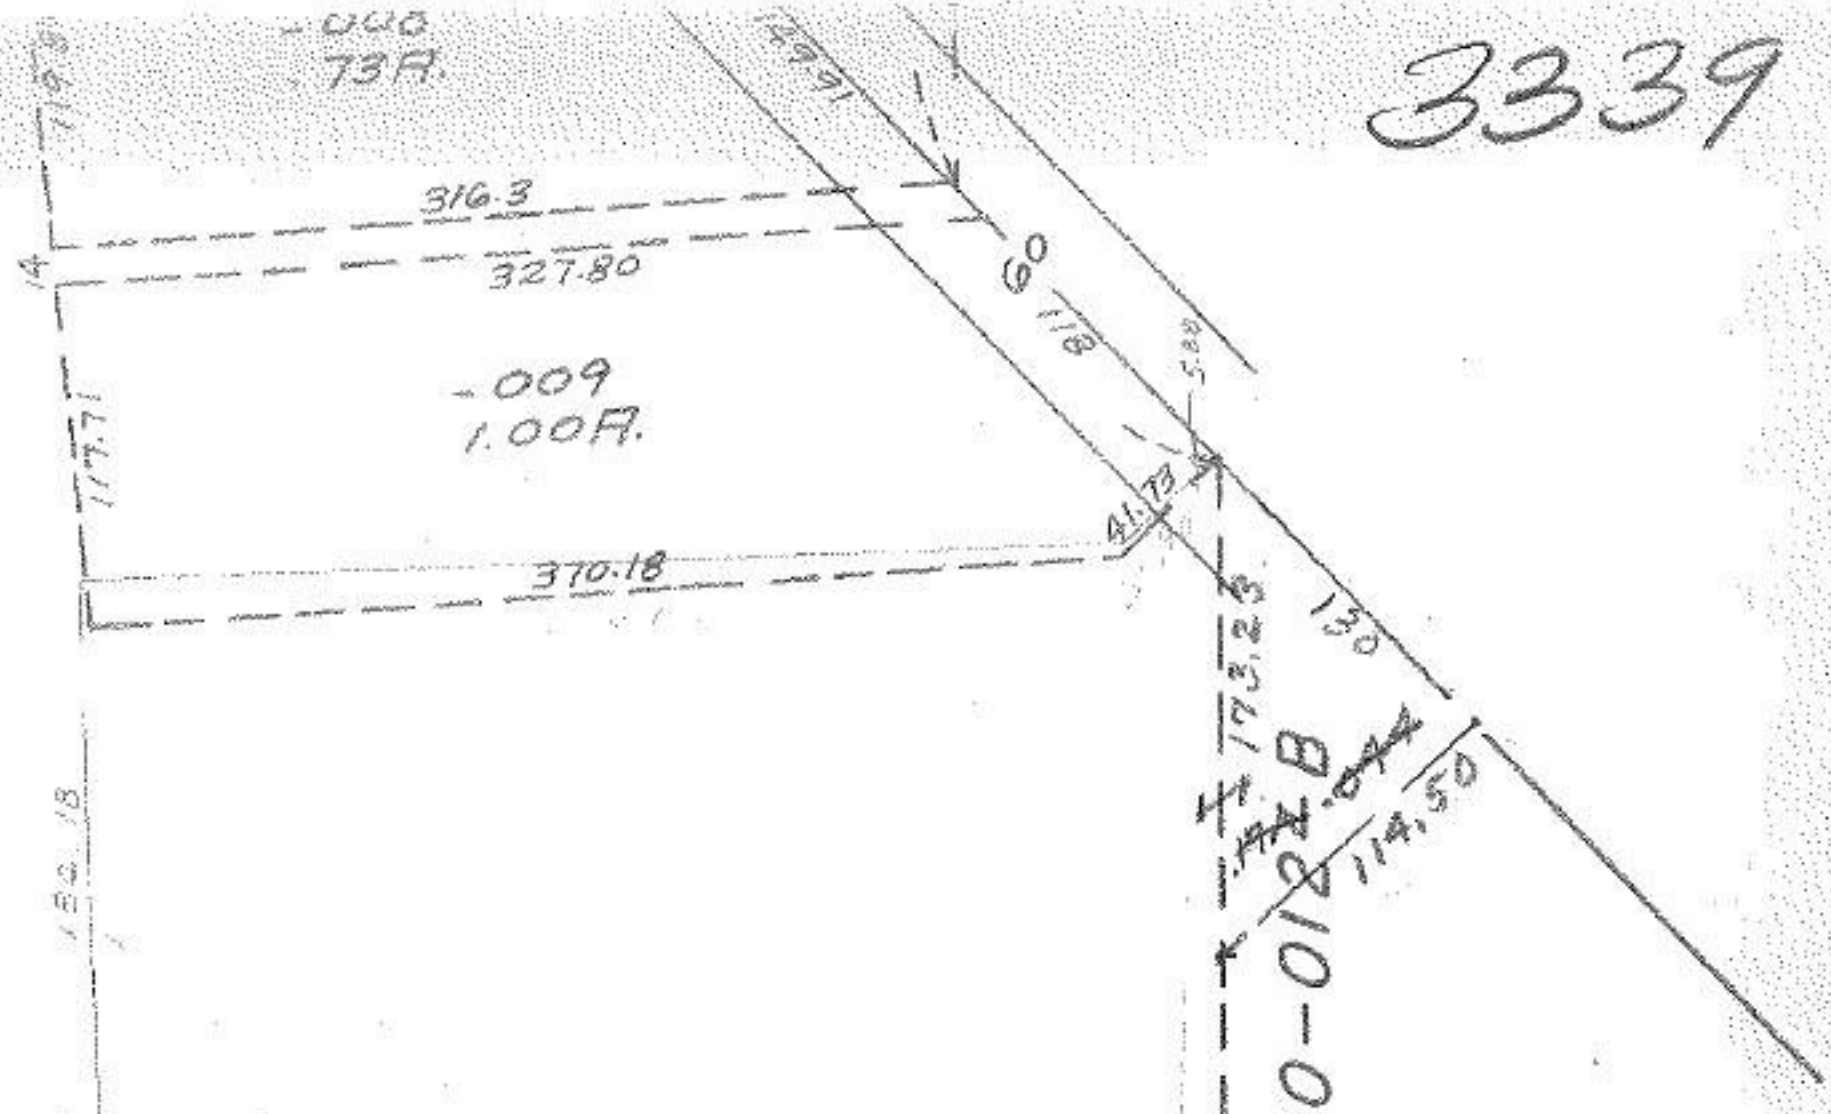

SEE 4-00-0127-B

N

JAN 6 ENT'D
see 3331

Jo

3339

APPROVED
LORAIN CO.
MAP DEPT.

7-16-86 L.L.

-046
-032
H. 23-A
16.40

-008
73 F.

-009
1.00 F.

854.54

894.6

179.91
316.3
327.80
177.71
370.18
41.73
5.00
173.23
114.50
130
854.54
894.6