

-001  
10.00A.

-001  
50.96A.

-00  
50.  
50.

-002  
50.96A.  
62


63

3354

7-28-86 L.L.

APPROVED
LORAIN CO.
MAP DEPT.
DATE 12/9/69
By L.S.-E
BY R.L. Kelling

-004  
99.25

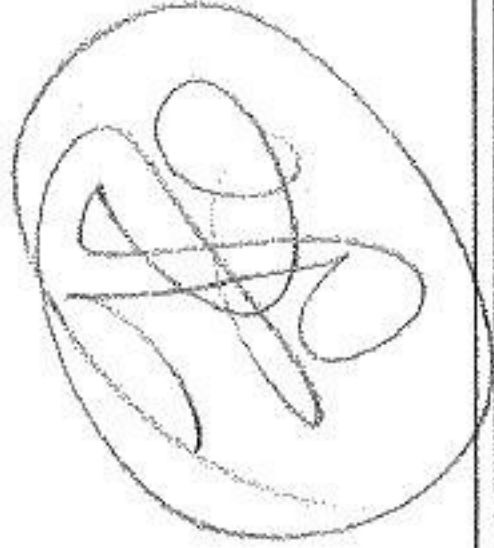

-007  
~~-005~~  
51.00A.  
49.59A.

512 1A1A  
5/2

WHITNEY

3354

3354

SITING