


3369

3369

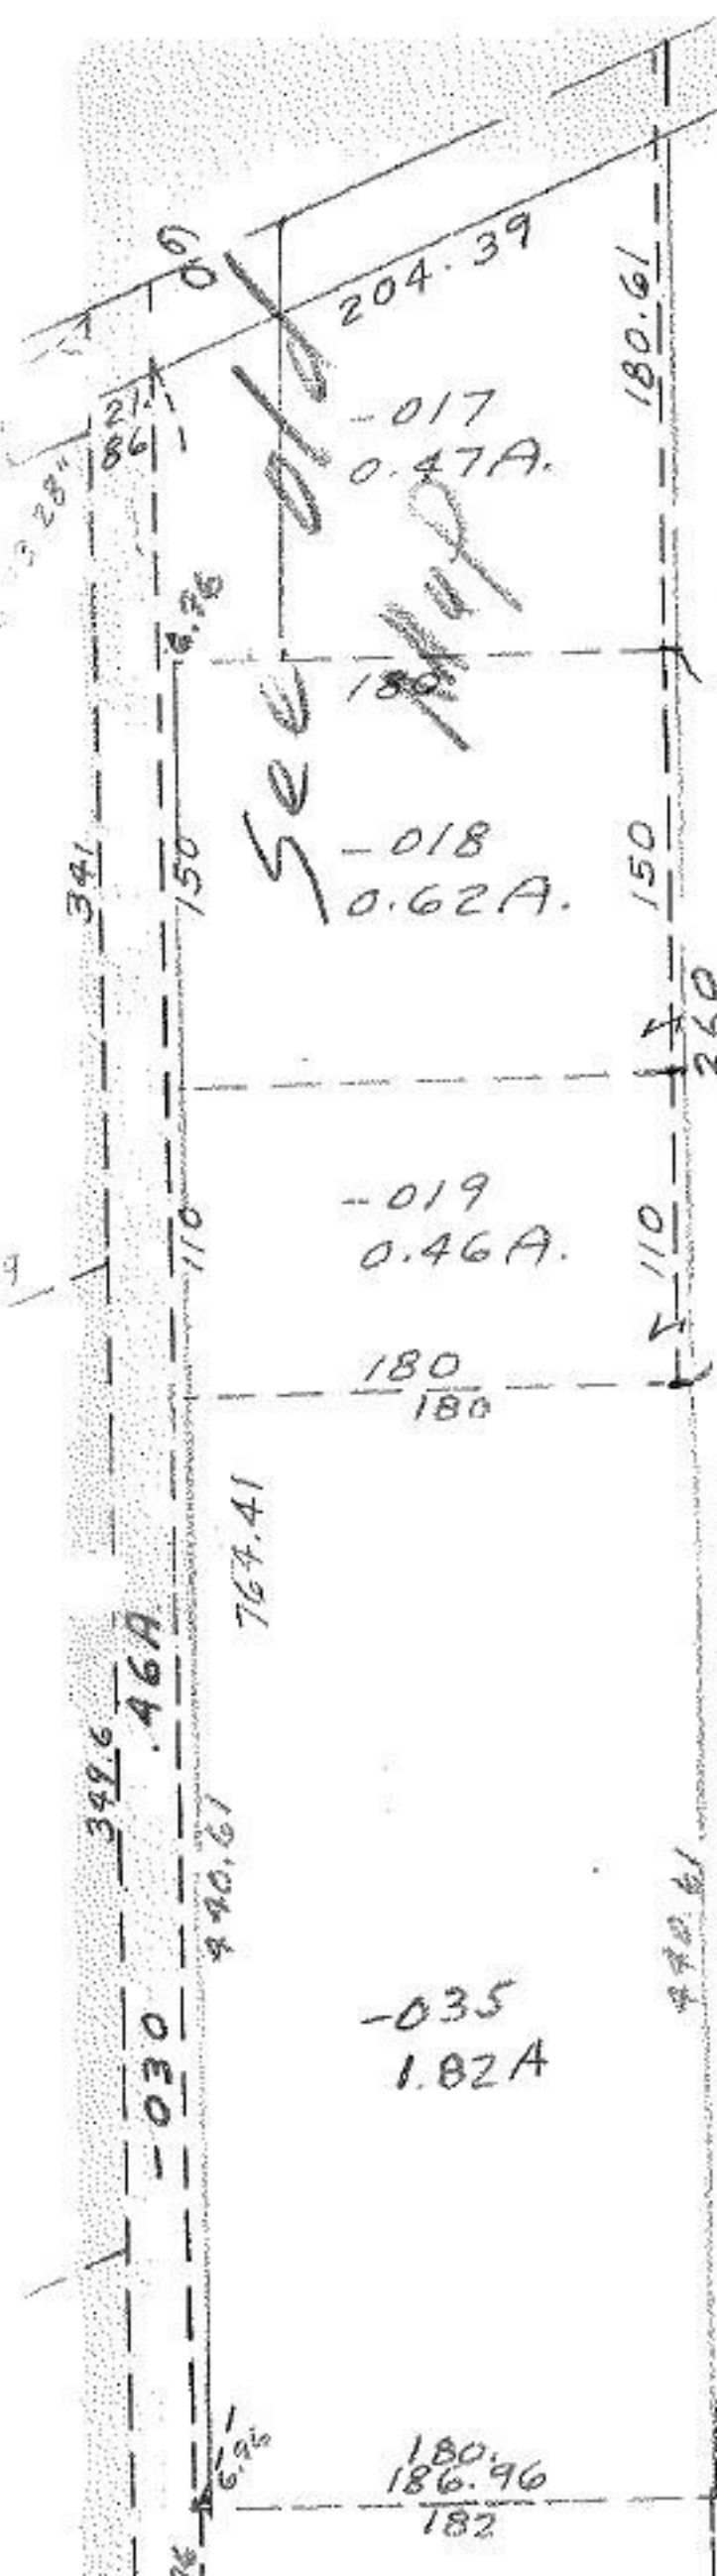

Parcel #2

12-16-91-21

-036
~~-031~~
 45.73A
 38.00A



3369
 APPROVED
 LORAIN CO.