



SEE 12-00-082-A

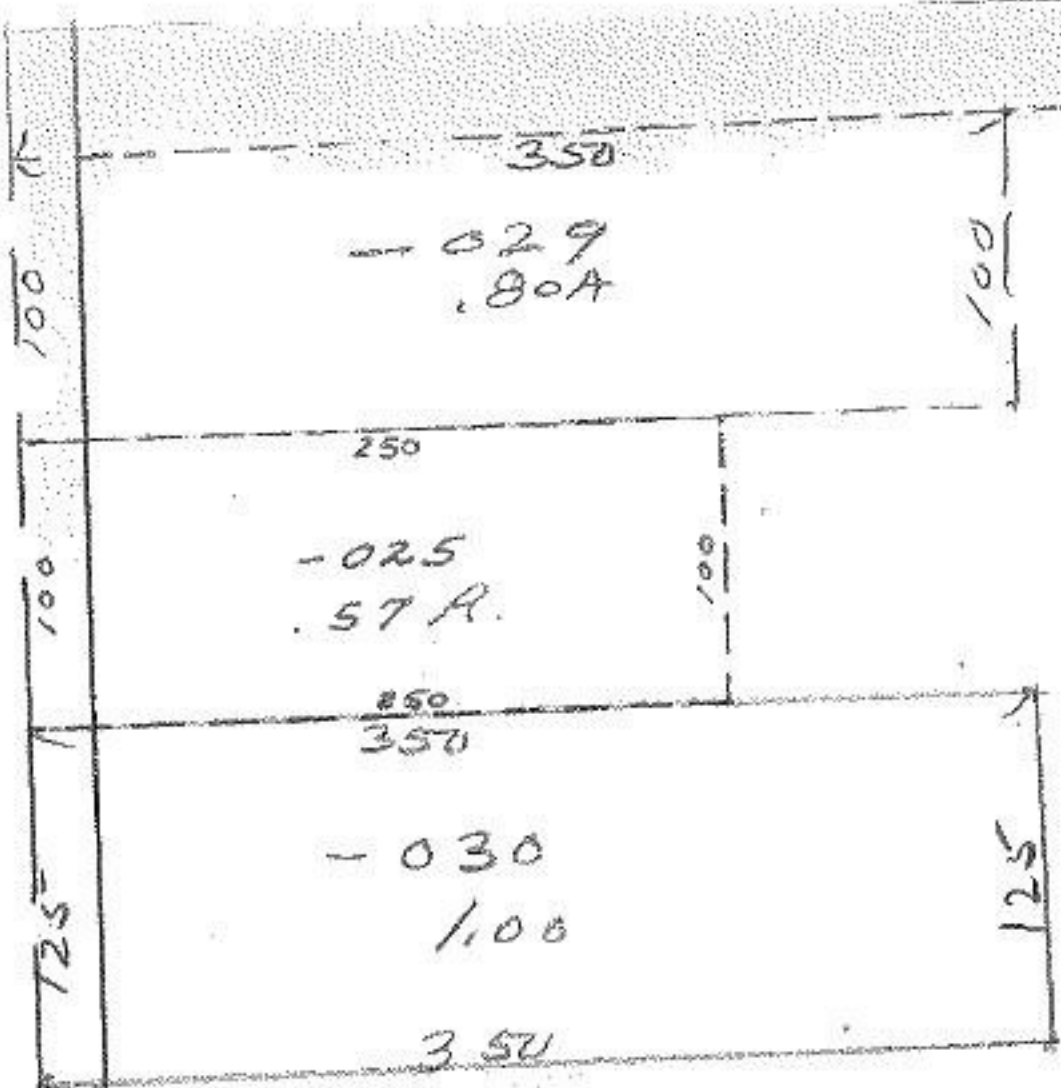

# 3379

3880

12-00-082 B

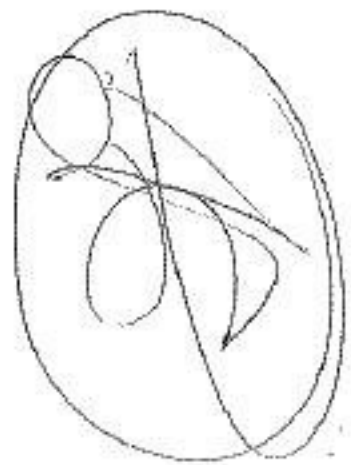

# 3379

# 3380

D.S.  
7-24-20

12-17-69

12-00-082-000-21