


3382

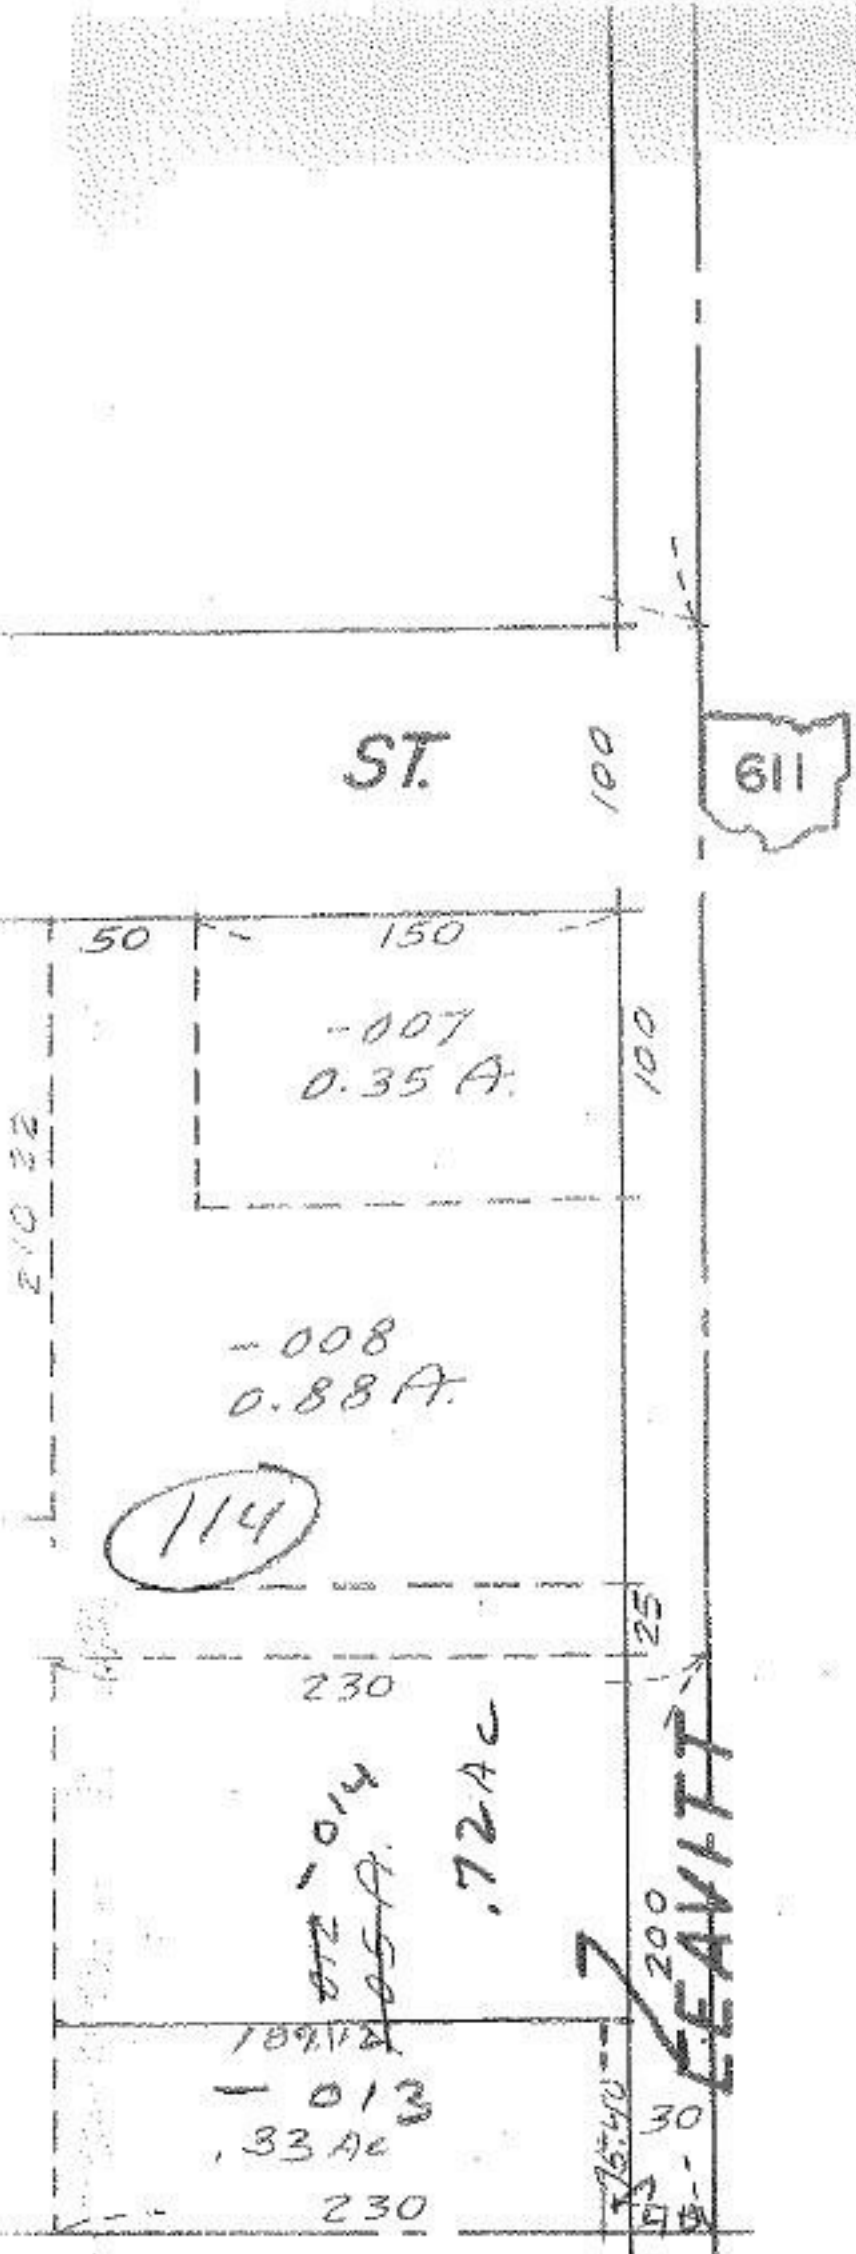

12-18-69

# 3382

APPROVED

LORAIN CO.

MAP DEPT.

DATE 12-18-69

2-02-023B

BY LWHall

7-16-86  
S.S.

# 3382