

SEE 12-00-040-A

3389

140°35'

Pt. 12-00-042-000-006
Pt. 14.52A.

APPROVED
 LORAIN CO.
 MAP DEPT.
 DATE 12/29/69
 P. 12-00-039-A
 BY
 B. J. Kelly

J. S.
7-28-86



305.71
410.72 RD.

635.38

910.72


500

600

100

183.22

12-29-69

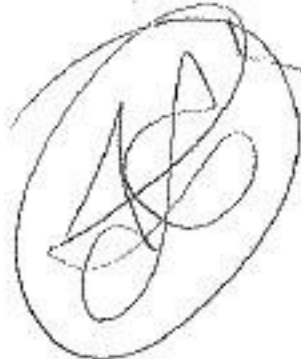

-047
-003
~~7.99A.~~
5.92

758.03

-046
2.07A.

180.6

109.4

124.78

68.7