

3422

- 003  
10.00A.

- 004  
20.00A.

- 006  
8.50A.

1775


- 005  
10.00A.

- 007  
5.00A.

250

1470

- 005  
~~- 001~~  
36.50A.  
35.50

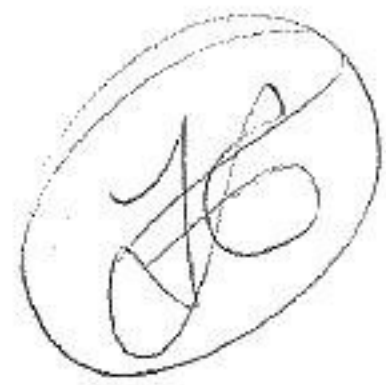

390.46  
403.87

- 004 1.A.

403.87  
390.46

16.8  
11.56

- 003  
72.50A.

28

3422

- 002  
50.25A.

EELEER

7-28-81-6

APPROVED
LORAIN CO.
MAP DEPT.
DATE 1/15/70
BY 15-D
BY

ST