

3424

100

180.28

-023
10.00 F.

-038
~~-024~~
10.00 F.
9.16 A

993.14

1360.7


65.66

-037

.84A

559.55

559.55

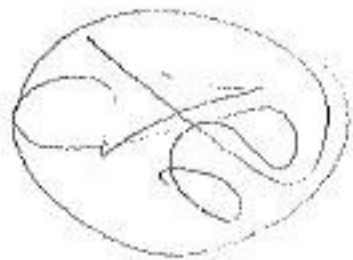

3424

180

APPROVED
 LORAIN CO.
 WASH DC
 1/15/20
 11-06-076-F
 R. Kelling
 JAN 29 ENT