

3488


ST.

#3488
 APPROVED
 LORAIN CO.
 MAP DEPT.
 DATE 1/23/70
 9-00-108B
 BY
 R. J. Kelling



3488

RD.

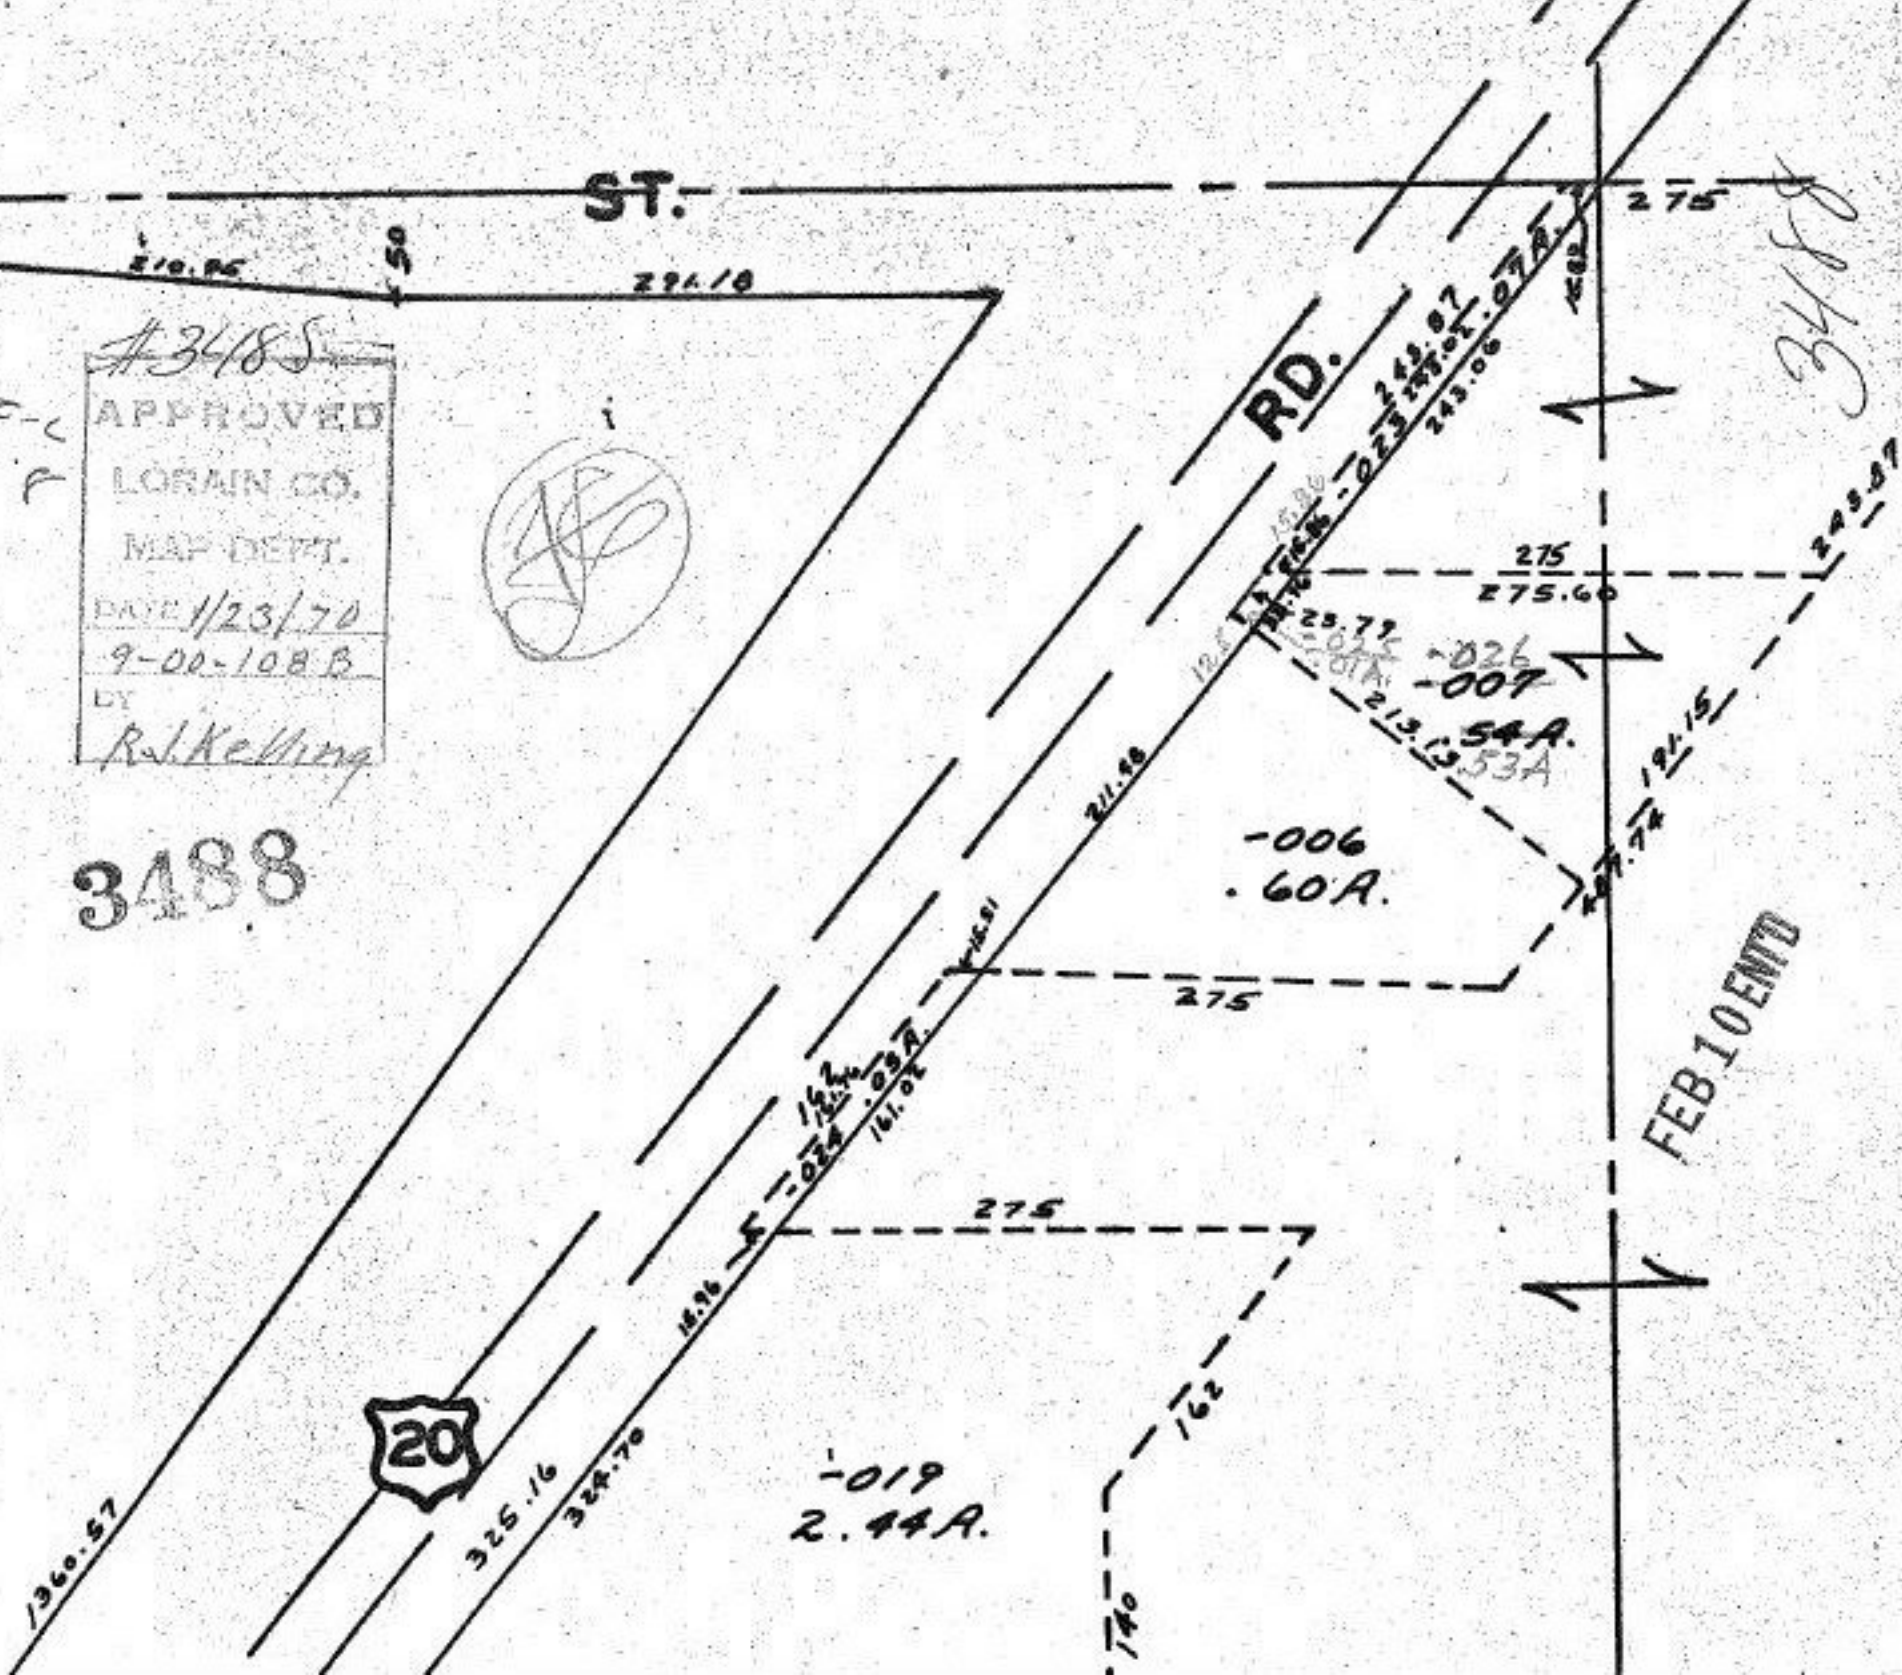

3488

FEB 10 1970

-019
2.44A.

-006
.60A.

-026
-007
54A.
213.13.53A