

3520

763 50

529.33

320.65

NS	-051	15A	51.57
:	-052	15A	:
:	-053	15A	:
:	-054	15A	:
:	-055	15A	4.50
:	-056	15A	:
:	-057	15A	:
:	-058	15A	685.90
:	-059	15A	:
:	-060	15A	:
:	-061	15A	:
:	-062	15A	7.35
:	-063	15A	9.4
NS	-064	15A	57
NS	-065	19A	55.90
NS	-066	17A	51.57
NS	-067	17A	:
NS	-068	17A	51.57



-087
7.69A


~~15.04A~~
7.35A
-088

218.50

40

250
150
~~084~~

135

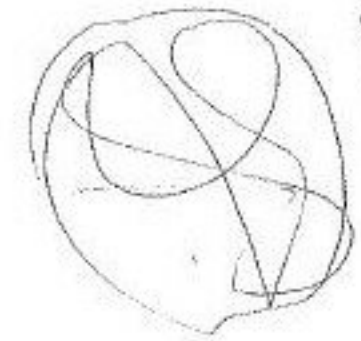

3520

MAR 1 1970

840.00
529.33
310.67

APPROVED
LORAIN CO.
MAP DEPT.
DATE 2/5/70
BY R. J. Kelly

199.93

7-16-86-8.6

Handwritten signature or initials over the stamp.

15471 0265