
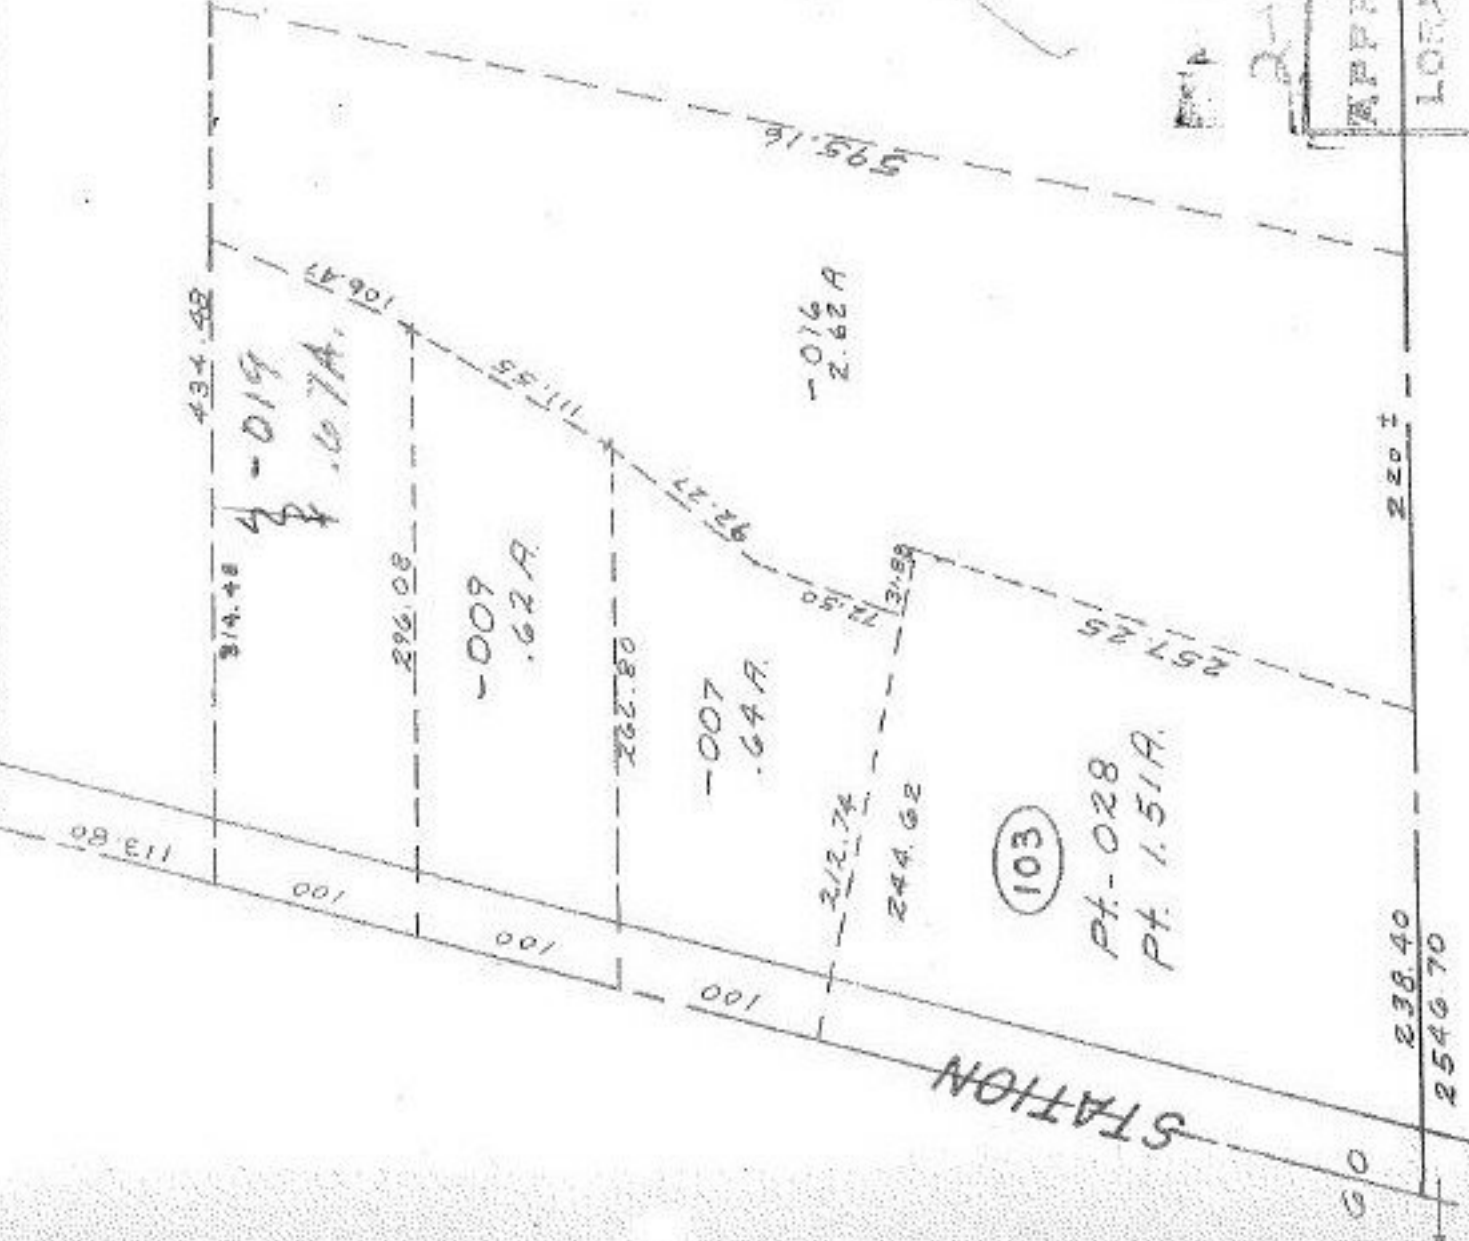


2558

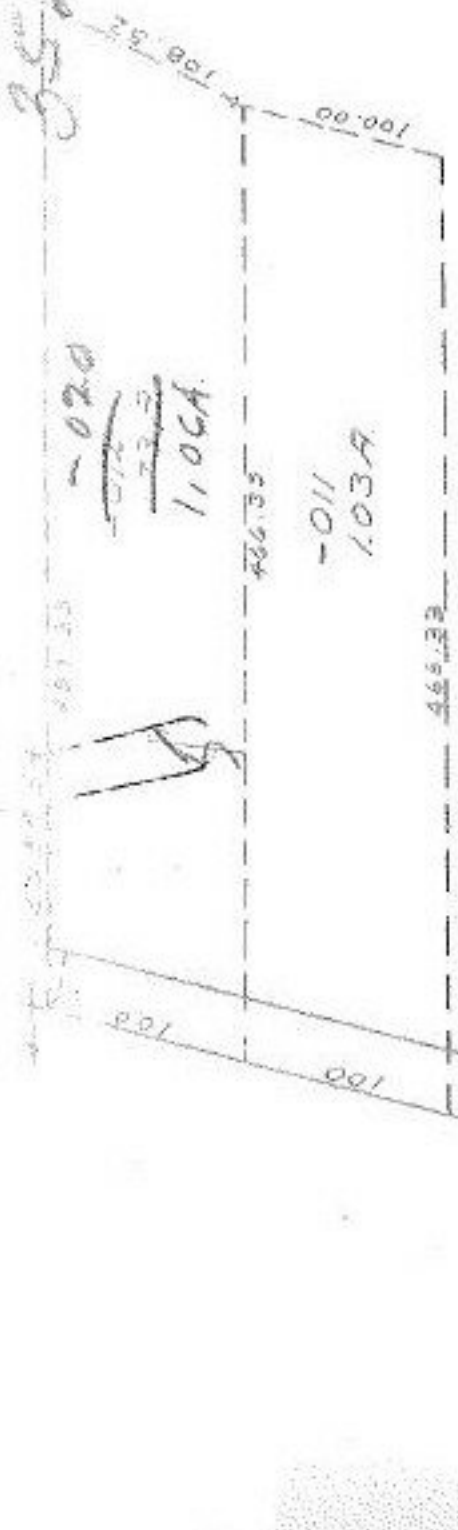

3528 #3
APPROVED
LOREAN CO.
MAP COPY
DATE 2/10/70
BY 1220-02508
SEE 10
8.8
7.04

Done on Map 8-13-70
L.H.A.
COLUMBIA TWP.
SCALE: 1" = 100'

STATION

PT. - 028
PT. 1.51A