


3533

RD. 60 1037.46 RD. 60 756.23

-022
52.45 A.

1015

-021
61.79 A.

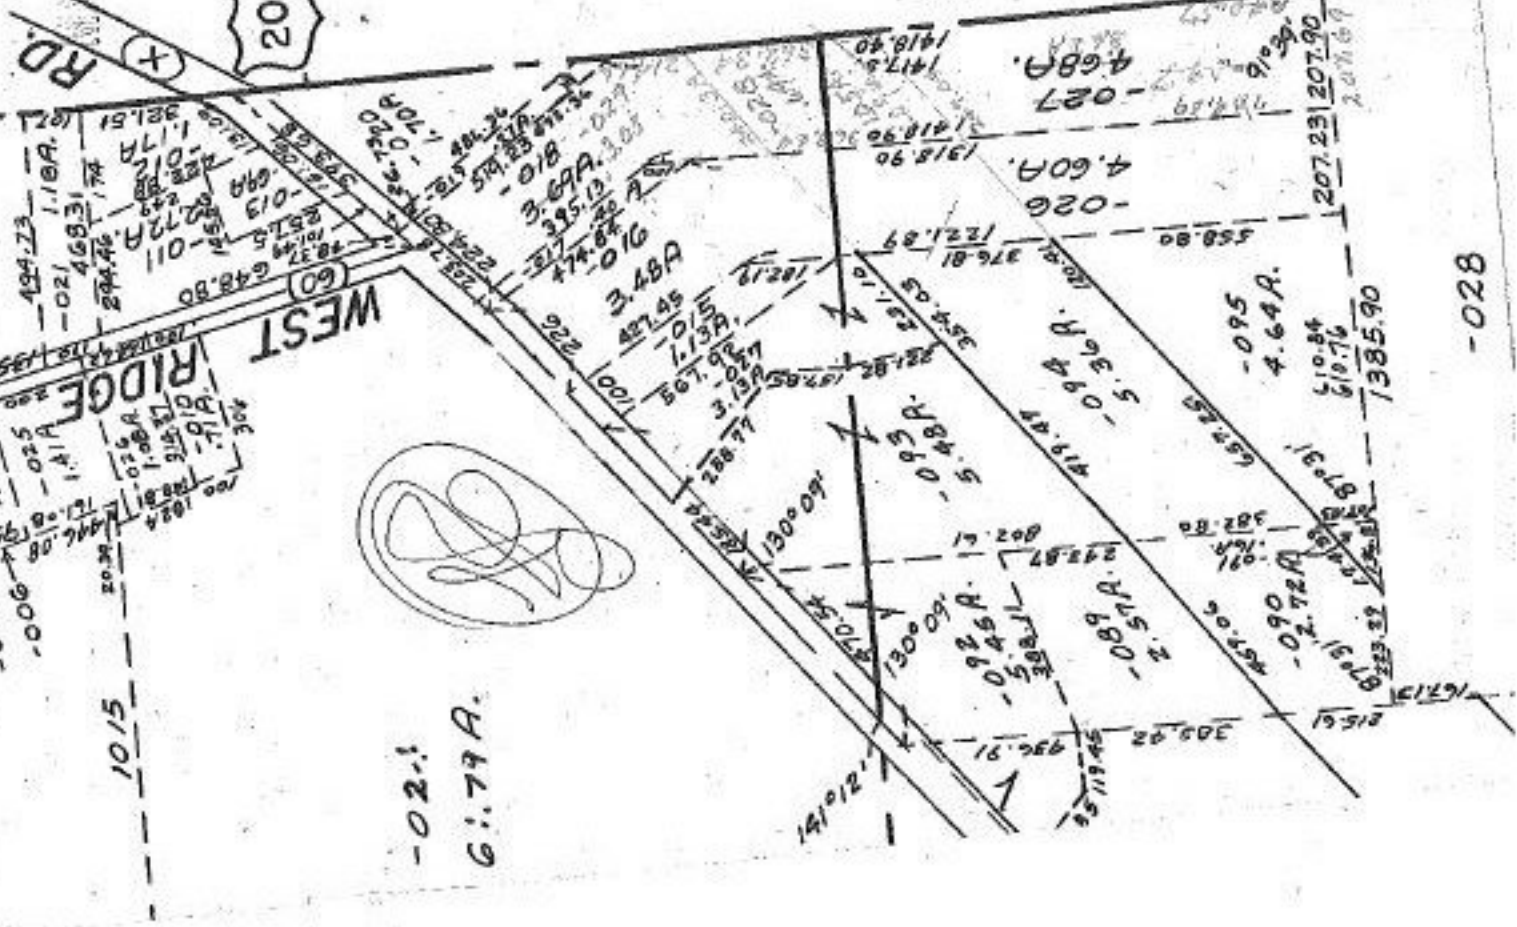

1418.90
369.64
1049.26
709.69
344.157

~~3588~~
3533

01.11.
04.20

APPROVED
LORAIN CO.
MAP DEPT.
DATE 2/13/70
BY
R. B. Bell
S. B.

7-3186

-028