


3548

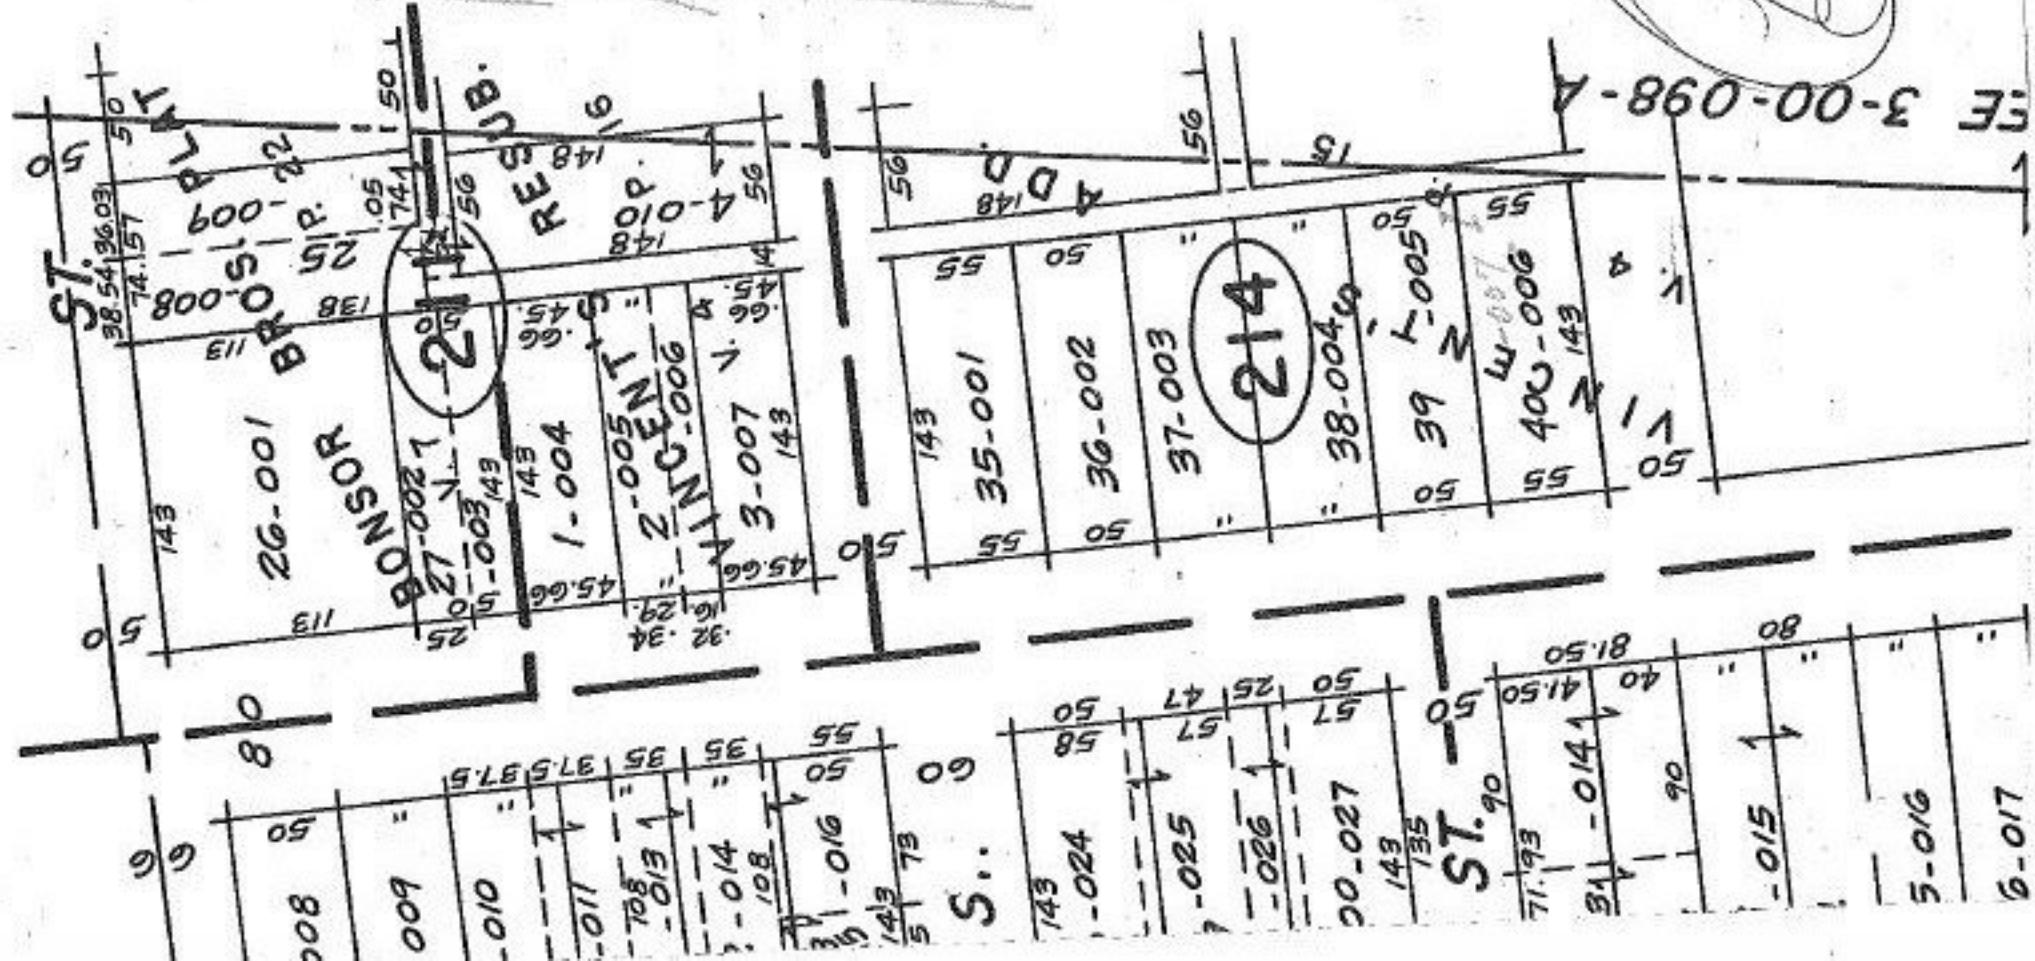

Alley Vac. By Ord.
#8613 12.16.63

3548 #1

APPROVED
LORAIN CO.
INSUR DEPT.
DATE 2/20/70
BY [Signature]
[Number]

[Signature]

MAR 11 1970

FE 3-00-098-A