


#3562  
 APPROVED  
 LORAIN  
 DATE 2-20-76  
 S-00-0371A  
 BY L.H. Hall

MAR 26 ENT'D

SEE 5-00

05-00-037-111-001  
 only Bldg. on 337, etc.

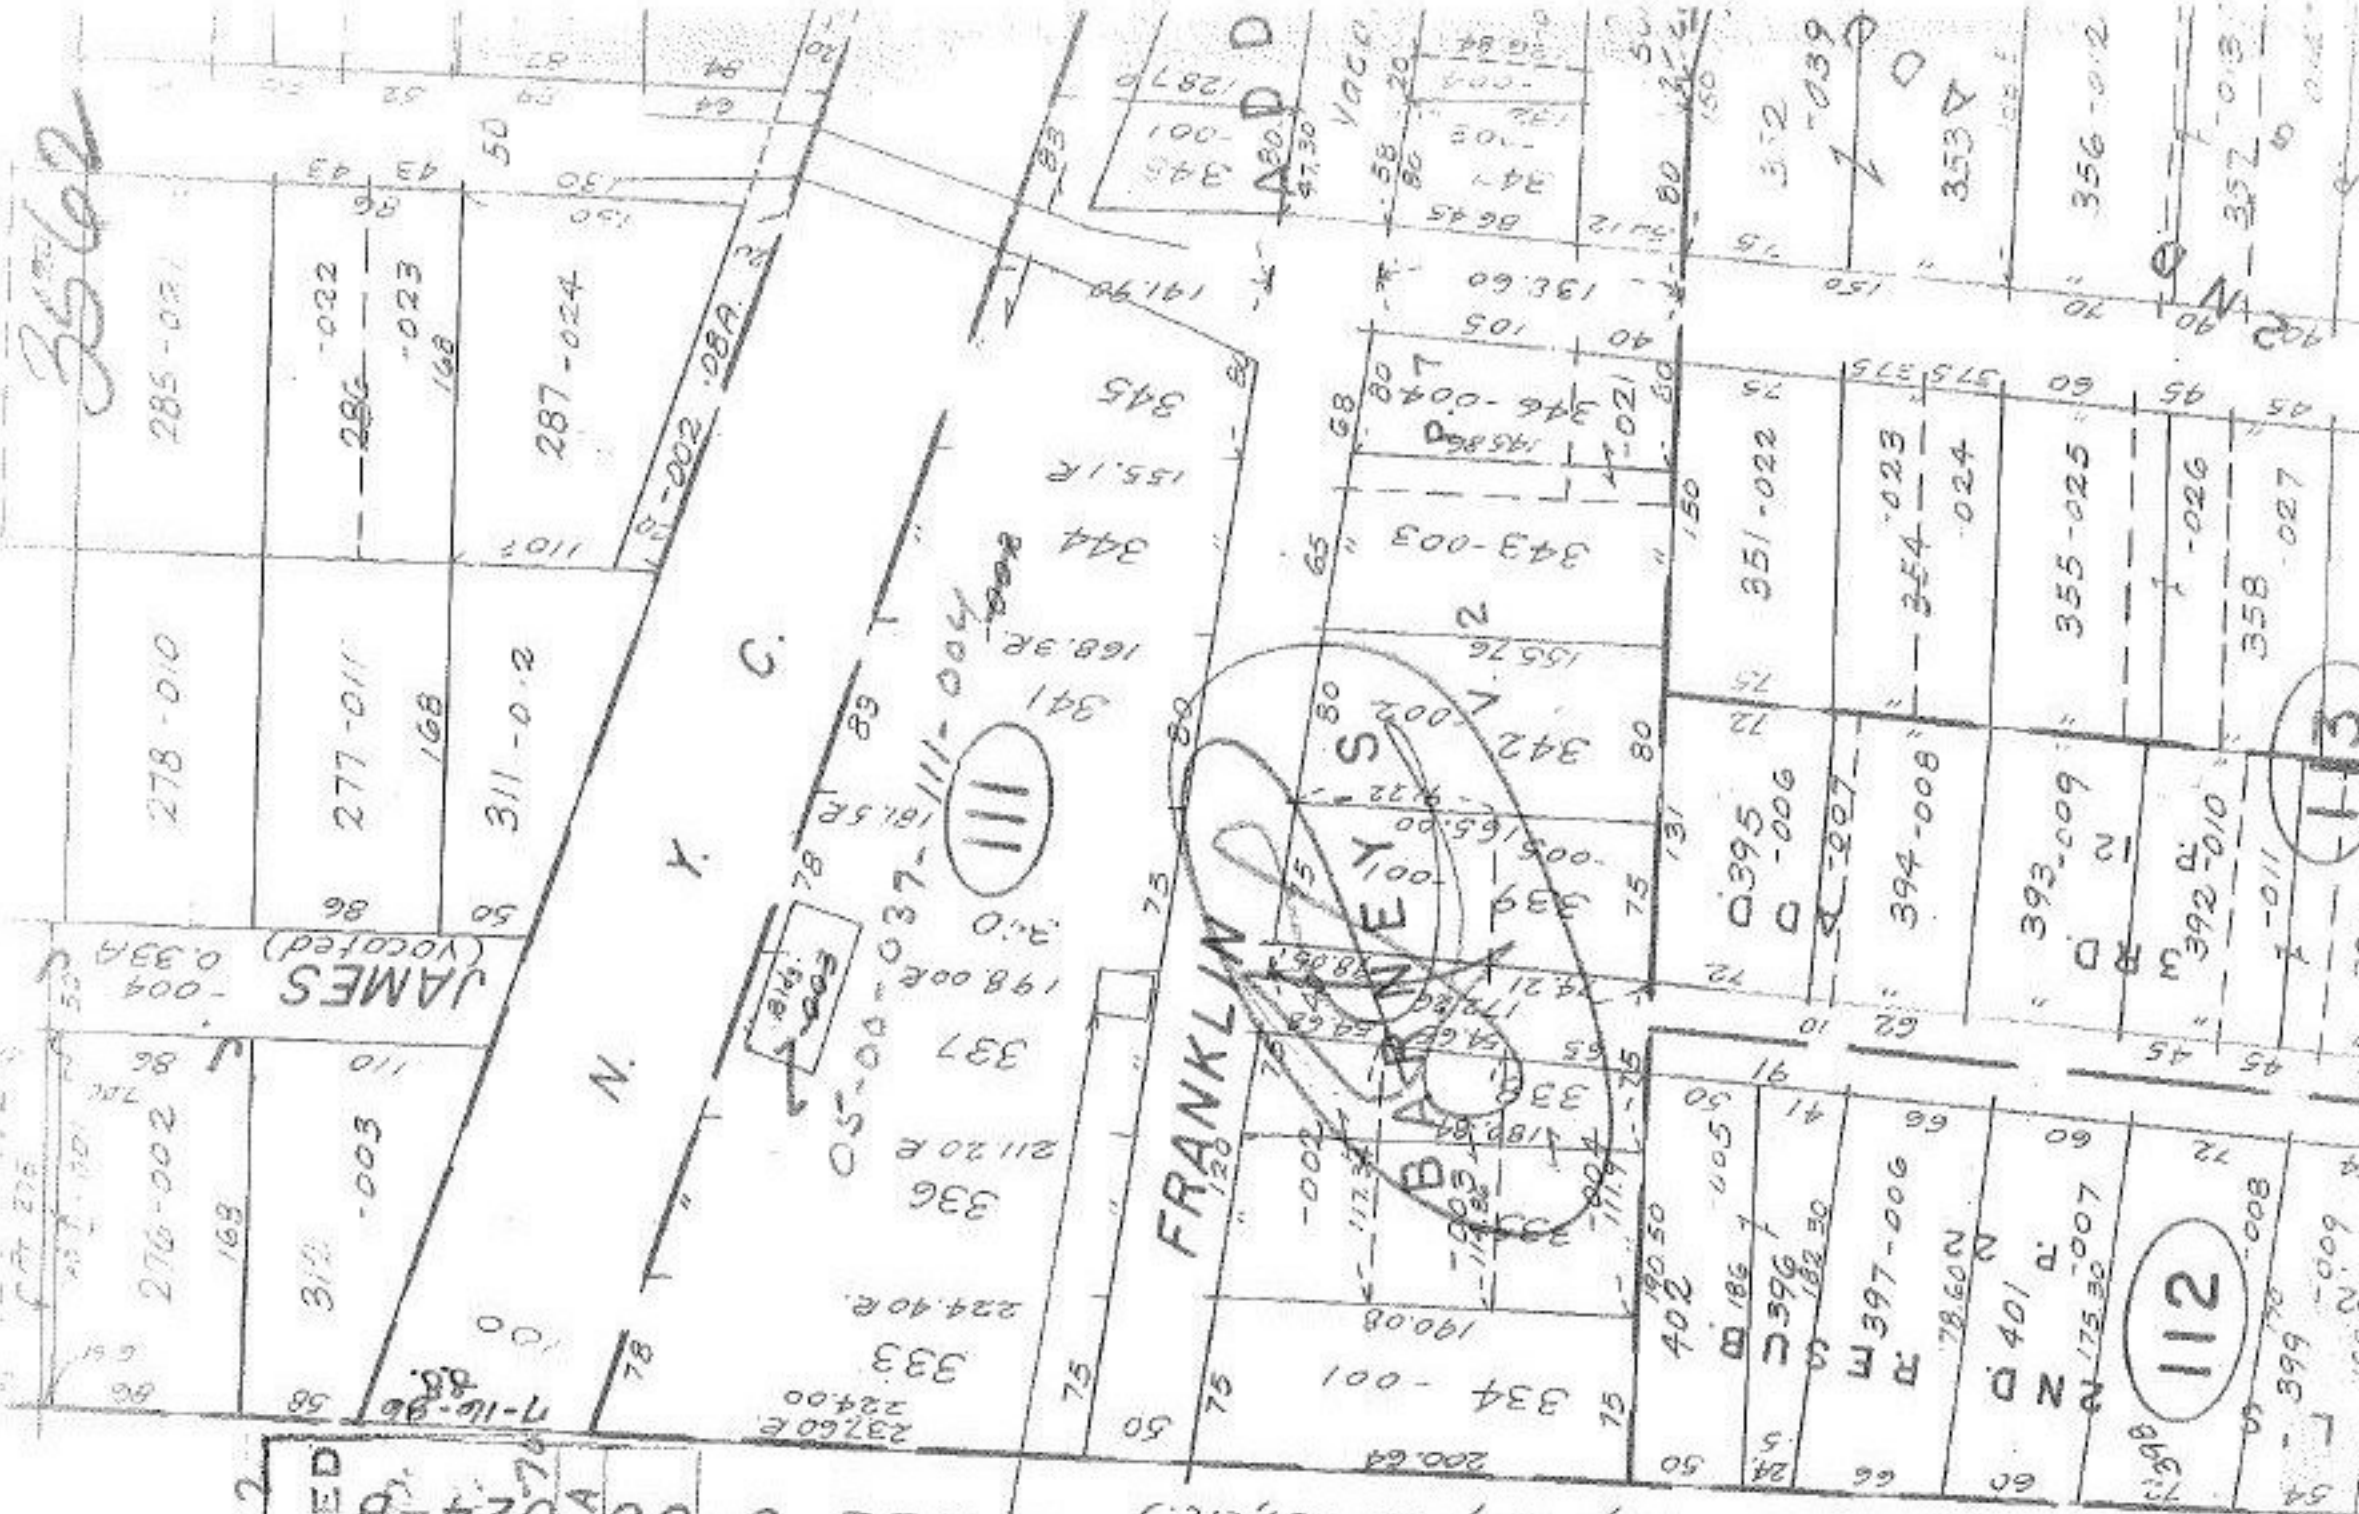

3562