


Note Tax Map Pages

12-00-038A } Changes on all pages in these  
12-00-039A }  
12-00-042B }  
12-00-043B }

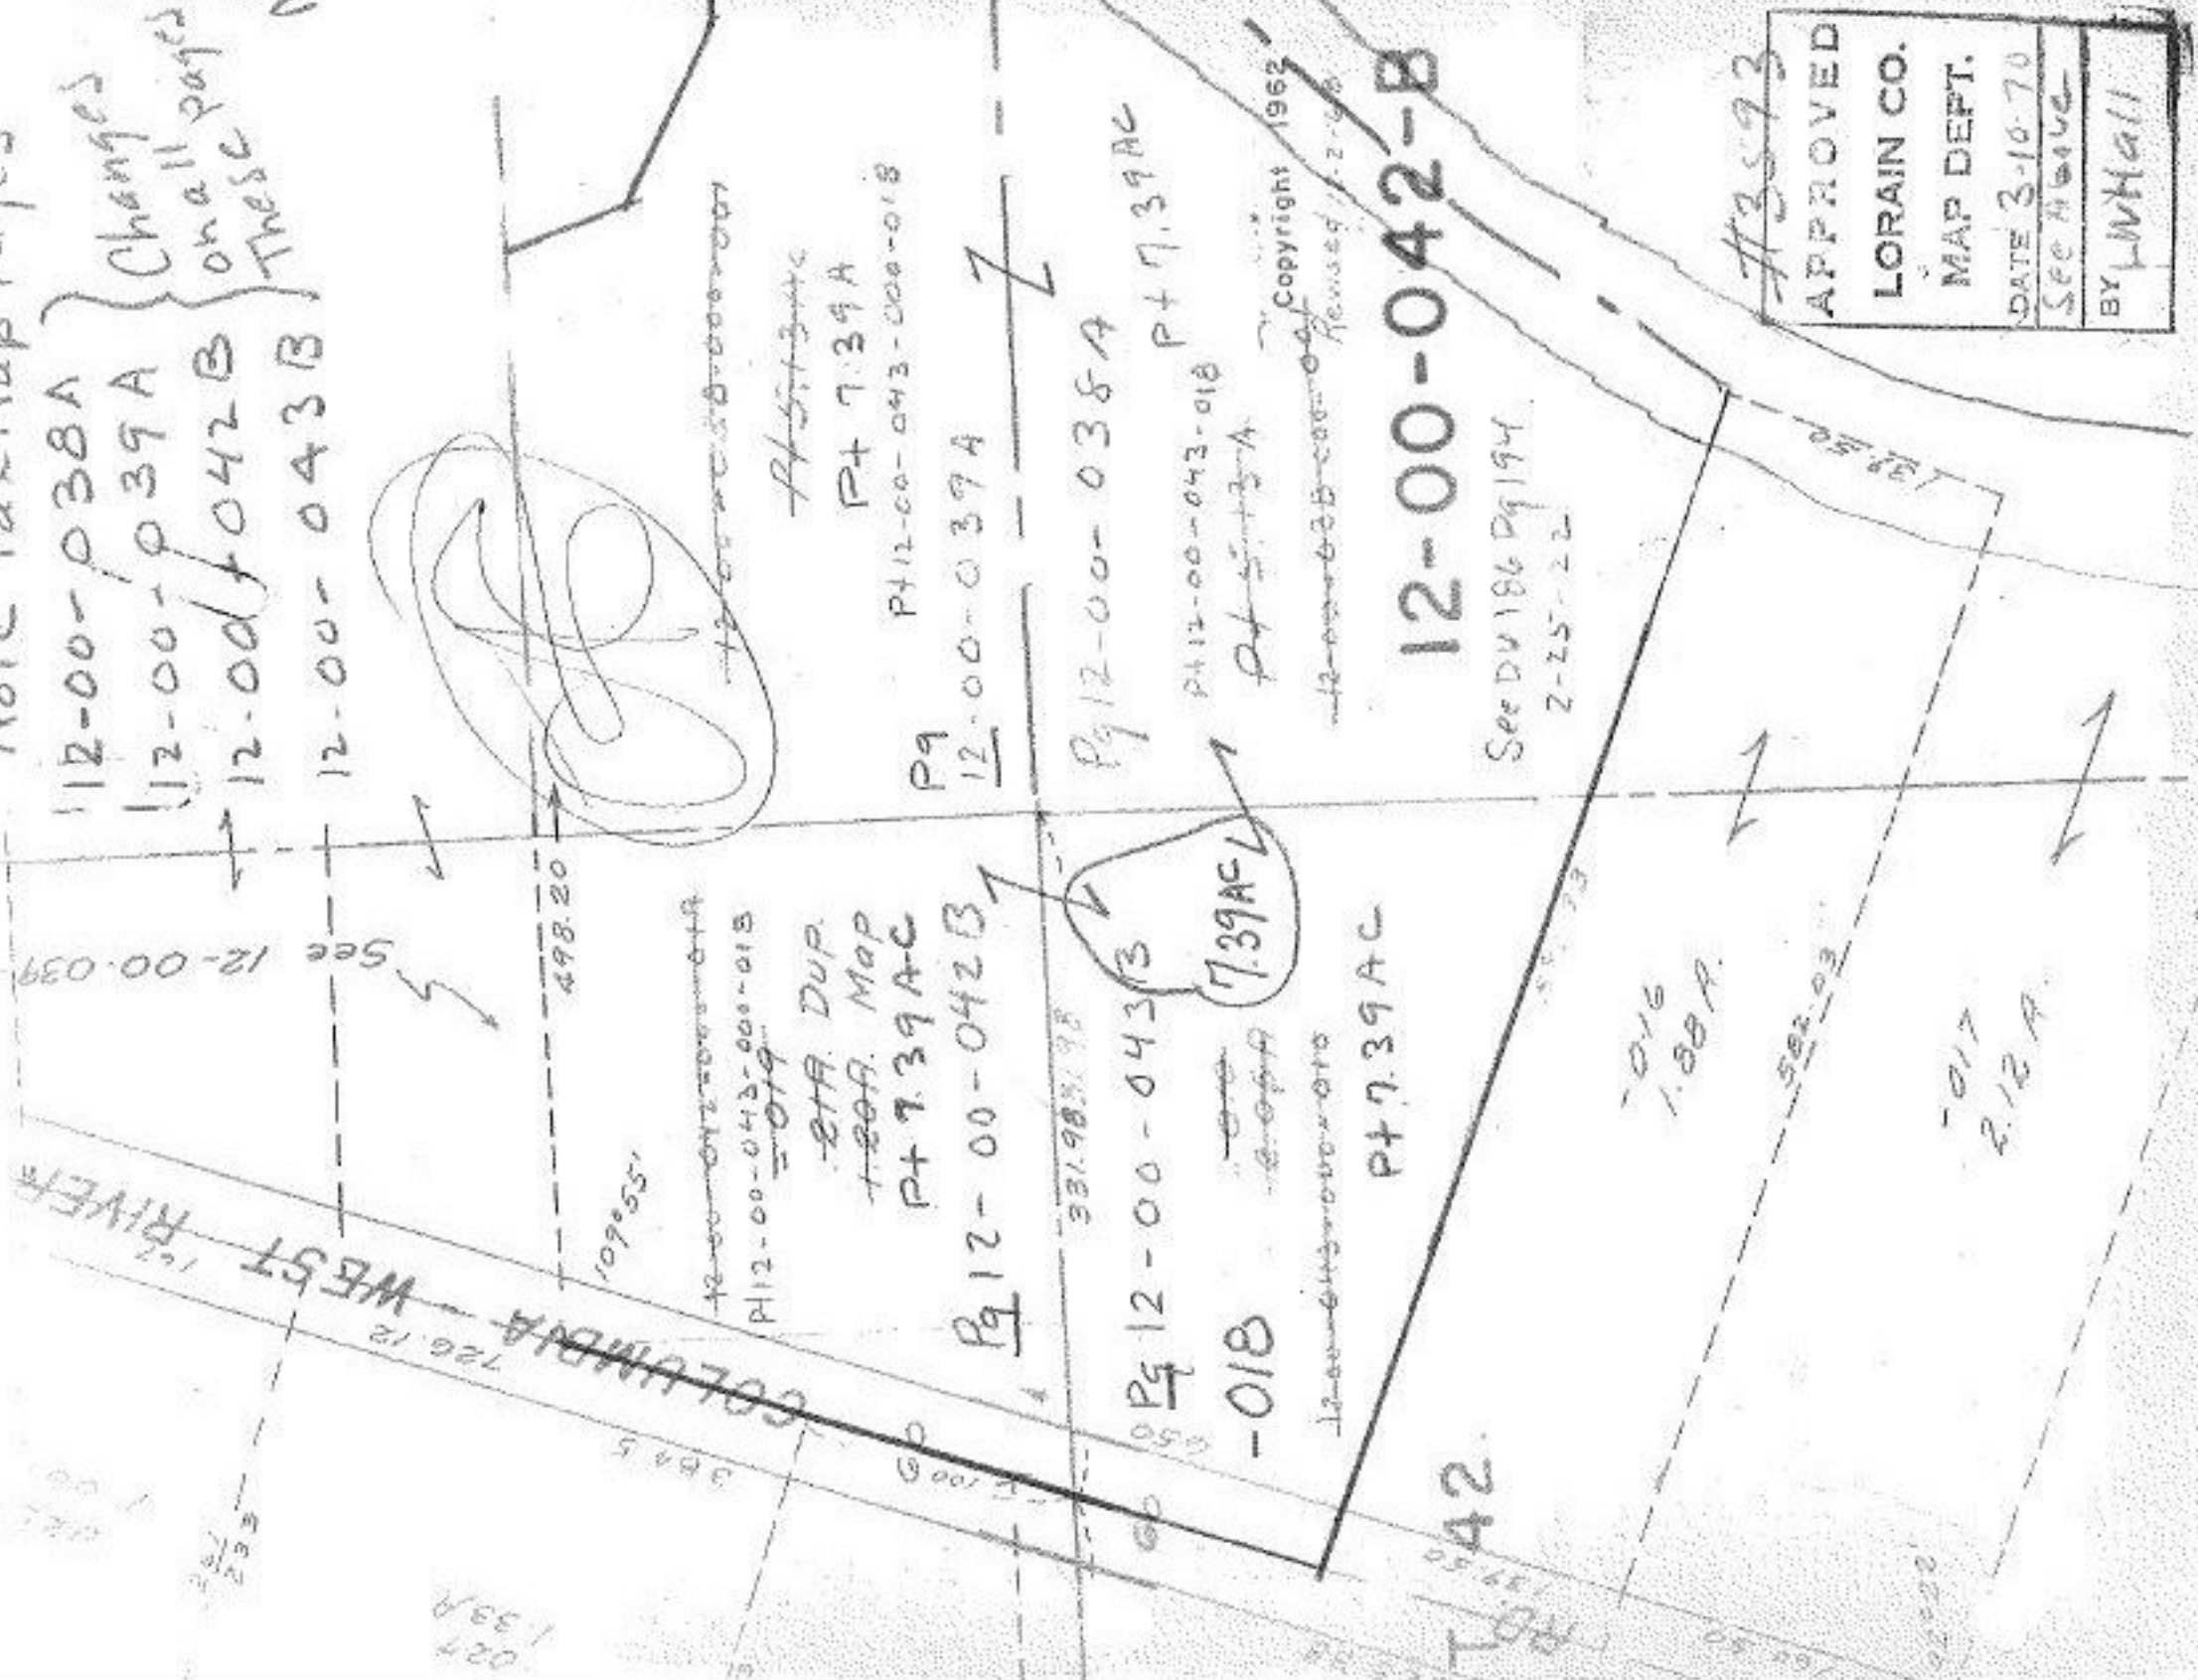

12-00-042-B

See DV 186 Pg 194  
2-25-22

#3593  
APPROVED  
LORAIN CO.  
MAP DEPT.  
DATE 3-10-70  
SEE ABOVE  
BY LWHall

COLUMBIA WEST RIVER  
126.12

~~12-00-042-000-018~~  
BTR. DUP.  
BTR. MAP  
P+7.39AC

Pg 12-00-042B

Pg 12-00-043B  
-018  
BTR. 739AC

~~12-00-038-000-018~~  
P+7.39AC

~~12-00-043-000-018~~  
P+7.39A  
P+12-00-043-000-018

Pg 12-00-039A

Pg 12-00-038A  
P+7.39AC  
P+12-00-043-018  
P+5.13A

Copyright 1962  
Revised 1-2-68

1.016  
1.88A

592.03

1.017  
2.12A

027  
1.33A

533

384.5

1.005

331.98

1.42

1.84

222.00

1.59A