



3600

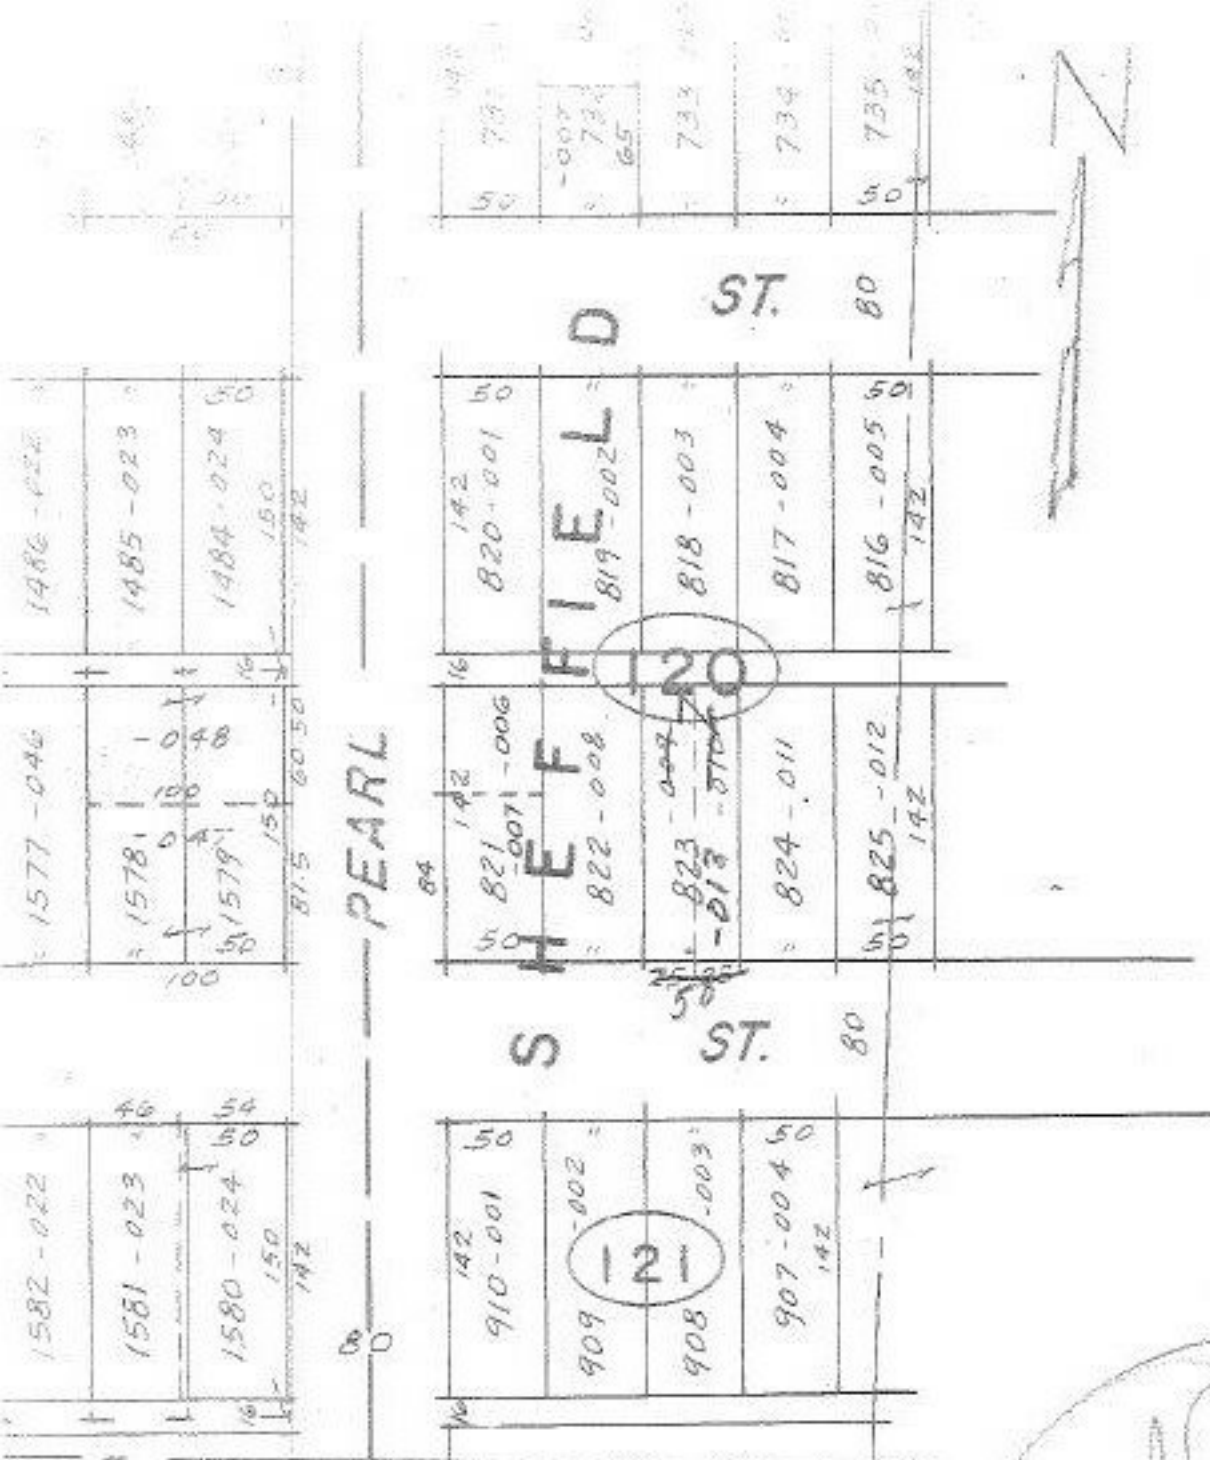

APPROVED
 LORAIN CO.
 MAP DEPT.
 DATE 3/12/70
 BY P.J. Halling

3600

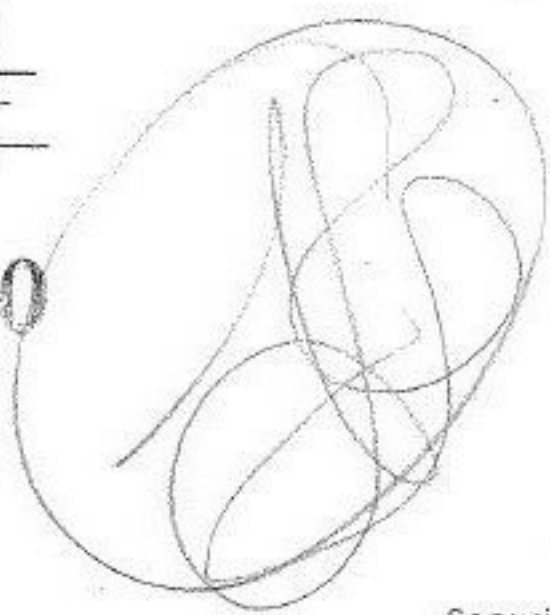

7-16-86
SS

Copyright 1964
REV. 2-2-64

LOTS 88 & 89

3-00-096-B

SS
 P.P.