


ST. 2



ST. N

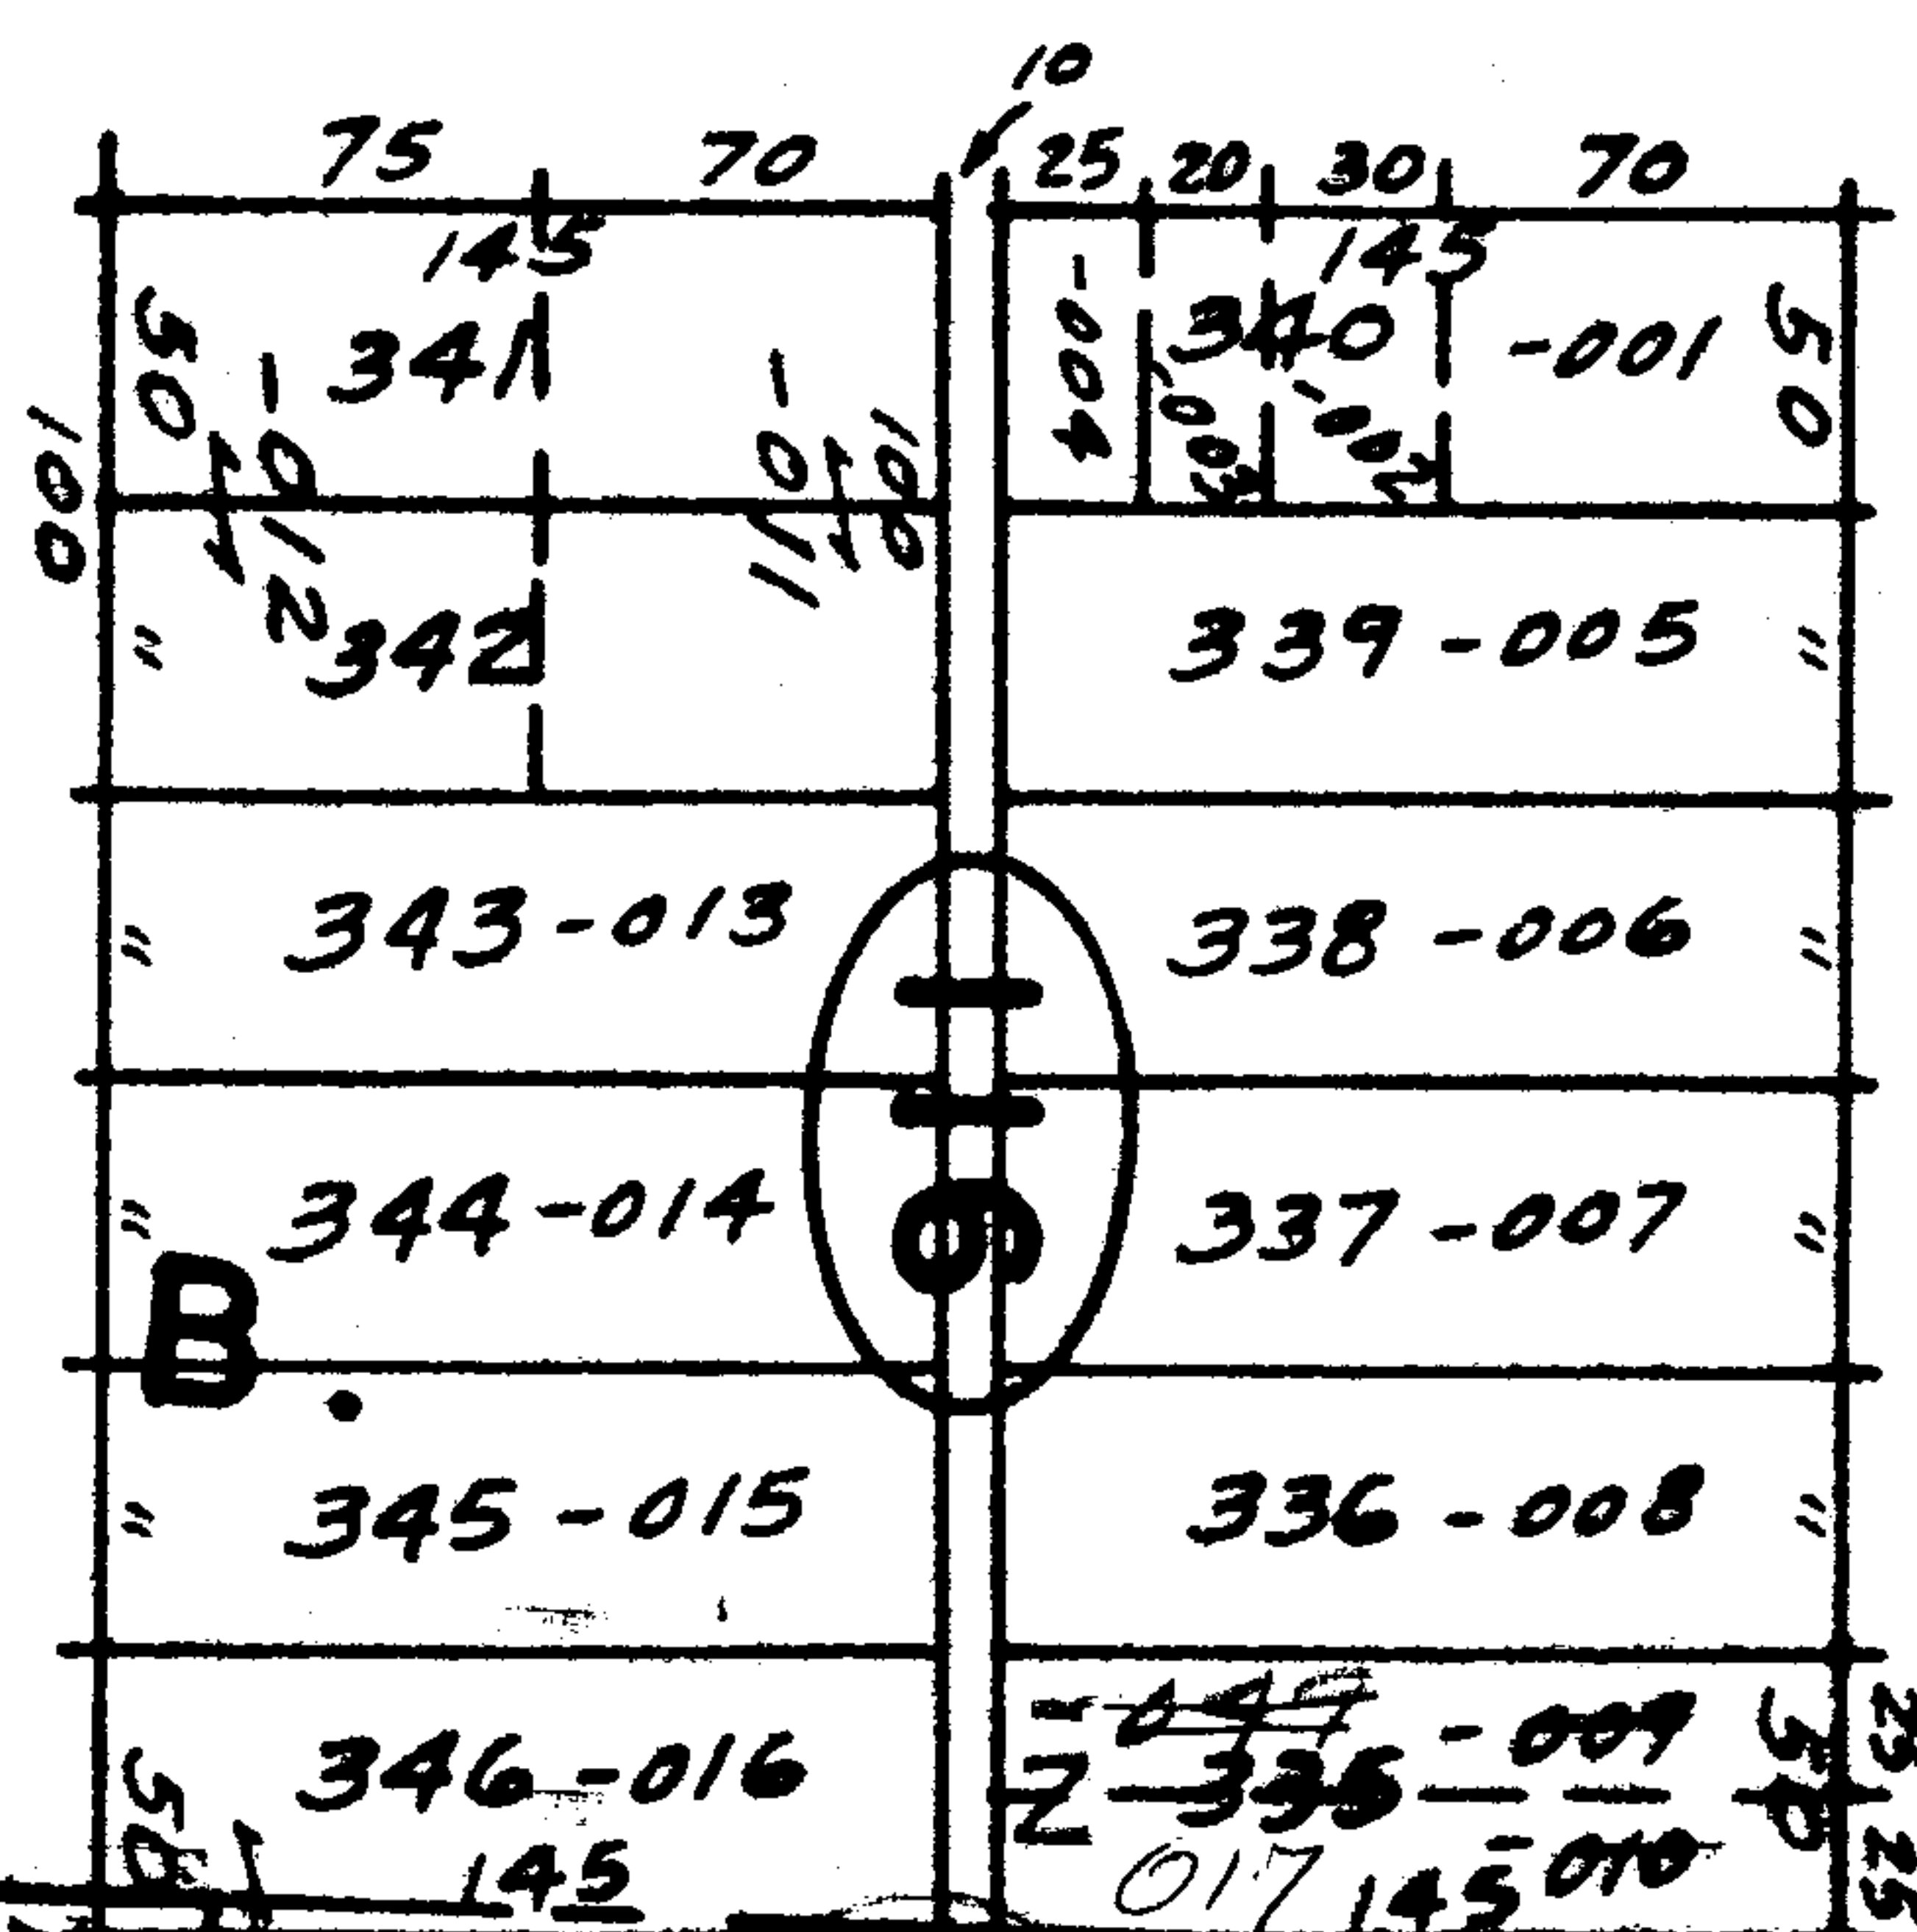

APPROVED  
LORRAIN CO.  
MAP DEPT.  
DATE 3/13/72  
73-00-006-  
MAY 20 ENT'D  
30005

30005  
MAY 20 ENT'D

