

18-00-016-B

387.22

~~-039~~
~~-018~~
10.00 F.
13.59

~~-020~~
1.84 F.

653.50 613.45 263.64

1291.85

21.90 85 212.87 122.0

35
209

~~-040~~
~~-034~~
15.72 F.
13.97

-033

1.18 F.

421.00
421.40

-023
2.00 F.

-021
1.82 F.

-022
1.54 F.

APR 15 1970


3628

1.48 F.

APPROVED
LORAIN CO.
MAP DEPT.
DATE 3/19/70
BY R. H. Kelleys

-038
1.97 F.

SEE 18-D

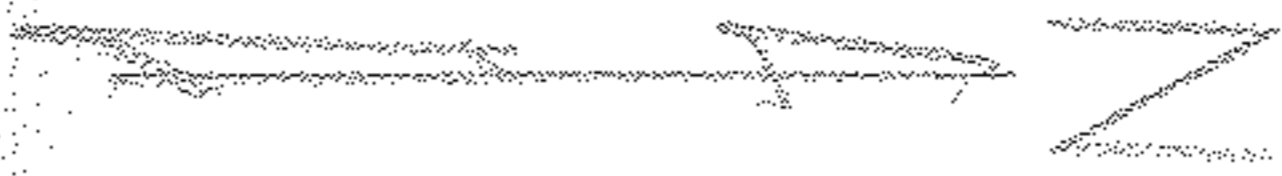

RD.

60

2.00

122.0

85

171.95

258.78

400

250

1285

404

165

502.77

337.22

1035.45 1291.85