


3635

SEE 5-D

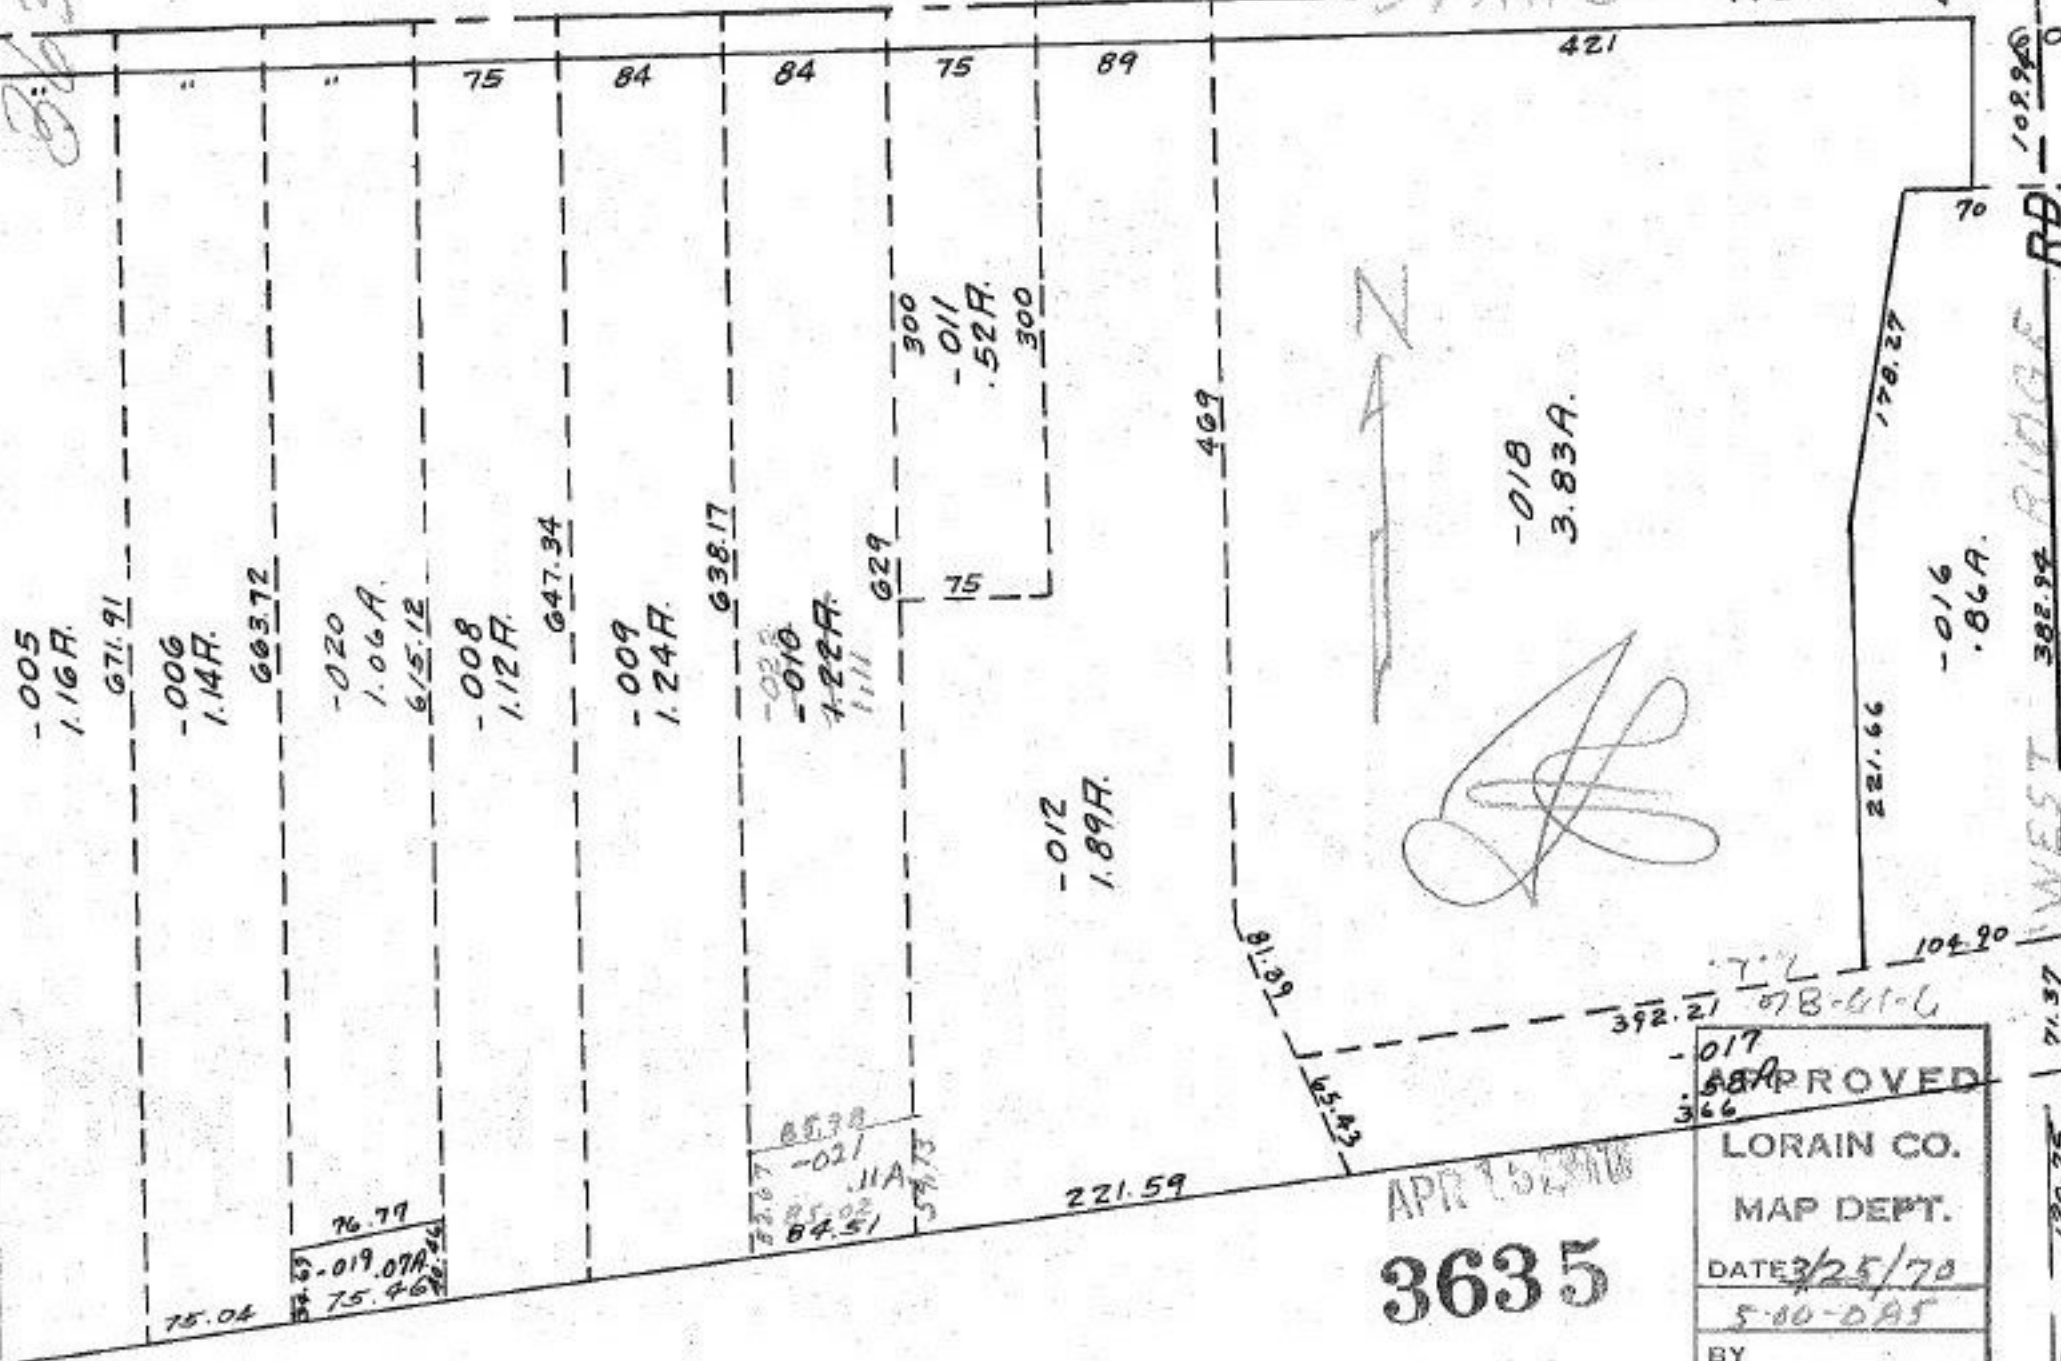

-005  
1.16R.

671.91

-006  
1.14R.

603.72

-020  
1.06A.  
6/5.12

-008  
1.12R.

647.34

-009  
1.24R.

638.17

-010  
4.22R.  
1.11

629

75

-012  
1.89R.

469



-018  
3.83A.

*[Handwritten signature]*

221.66

-016  
.86A.

178.27

70

109.94

75.04

76.79

-019  
1.07A.  
75.46

85.38  
-021  
1.11A  
85.02  
84.51

221.59

81.39

65.43

392.21

7° 2' 10" 78-61-6

104.90

71.37

180.75

3635

APR 15 1970

TURNPIKE

|                         |
|-------------------------|
| -017<br>366             |
| APPROVED                |
| LORAIN CO.<br>MAP DEPT. |
| DATE 3/25/70            |
| 5-00-0A5                |
| BY<br>R. J. Red         |

WEST RIDGE RD.

STANB RD.