


3643

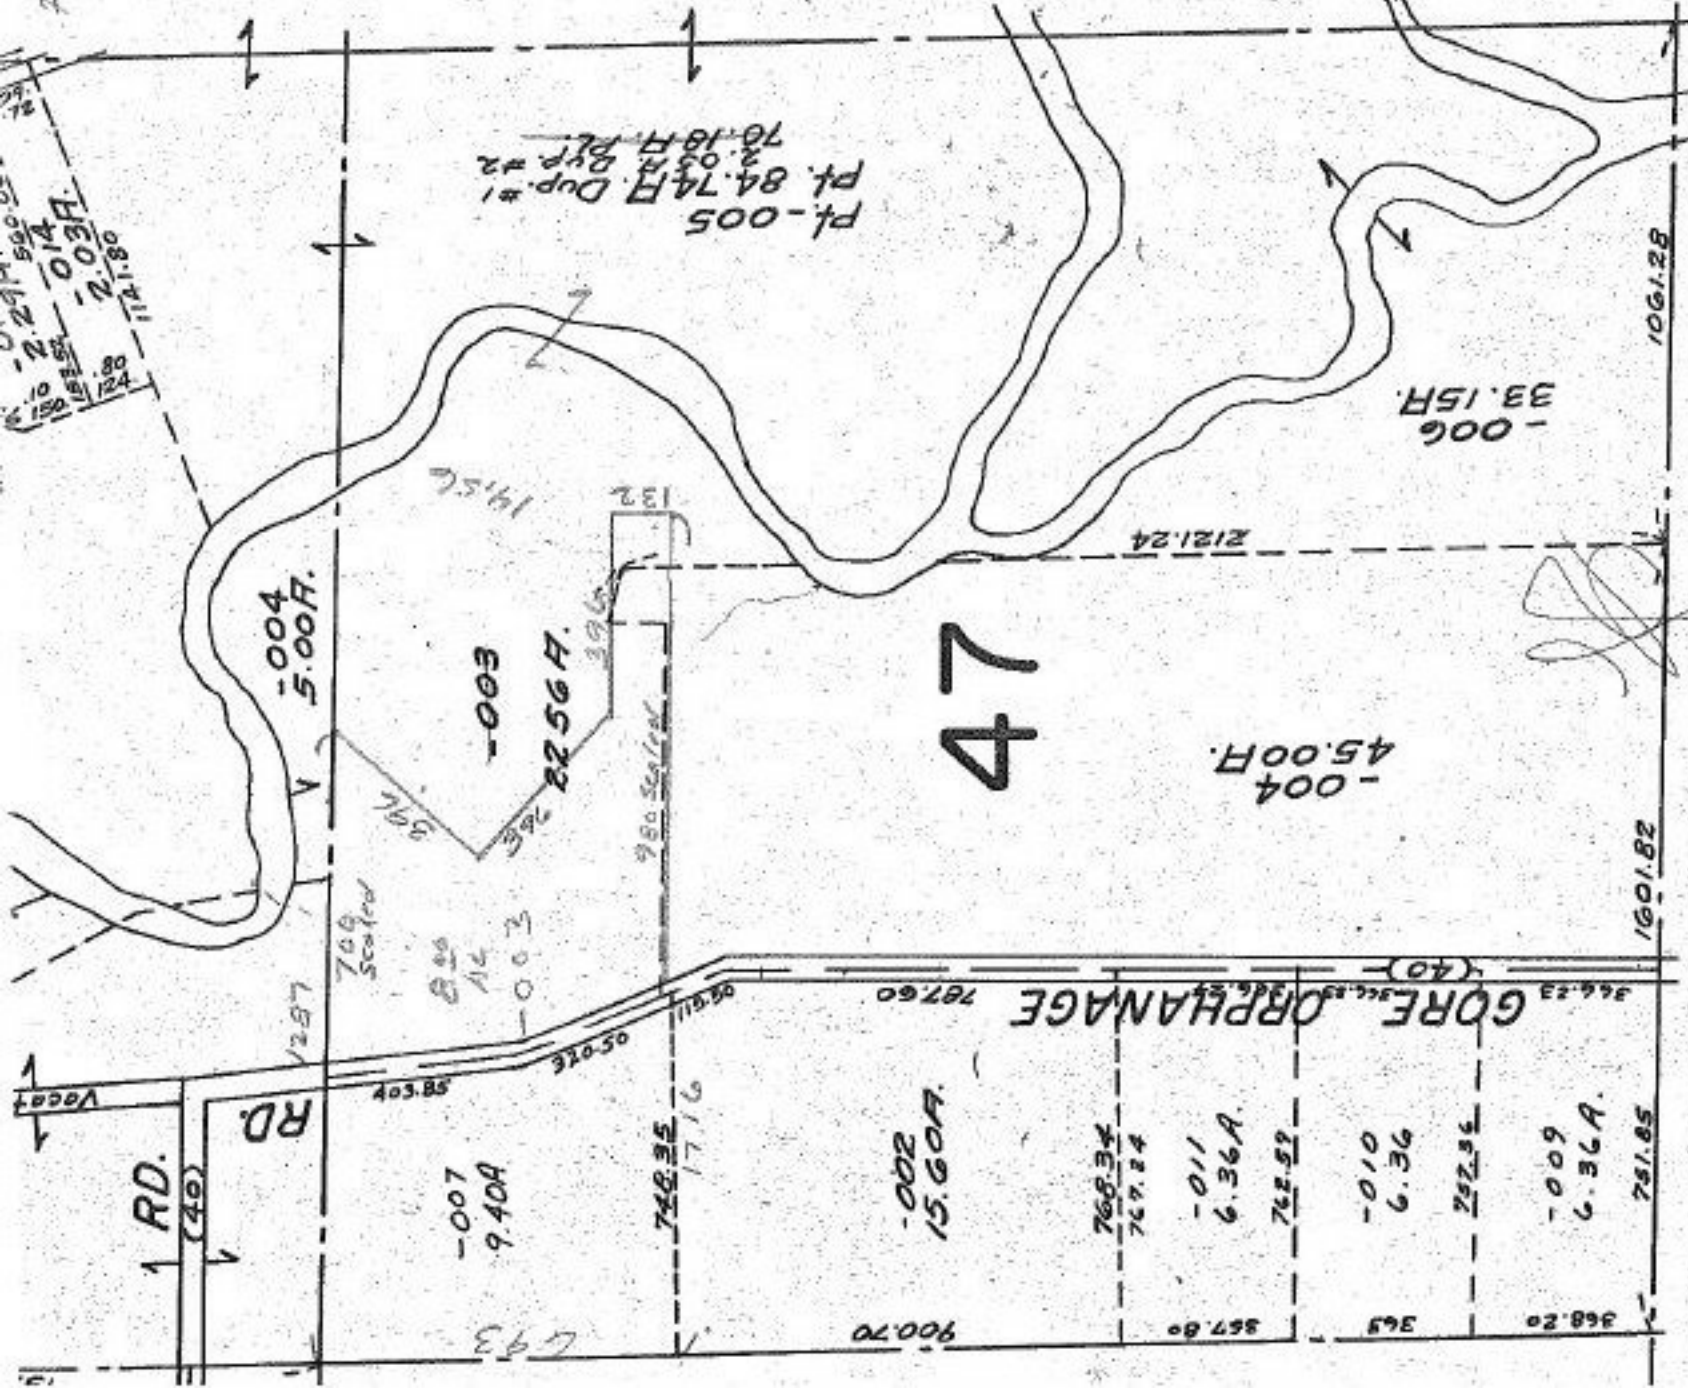

1-E

JUN 5 1950

PTS 17, 18, 31 THRU 34, 47, 48
GORE STRIP PT. LOT 27