
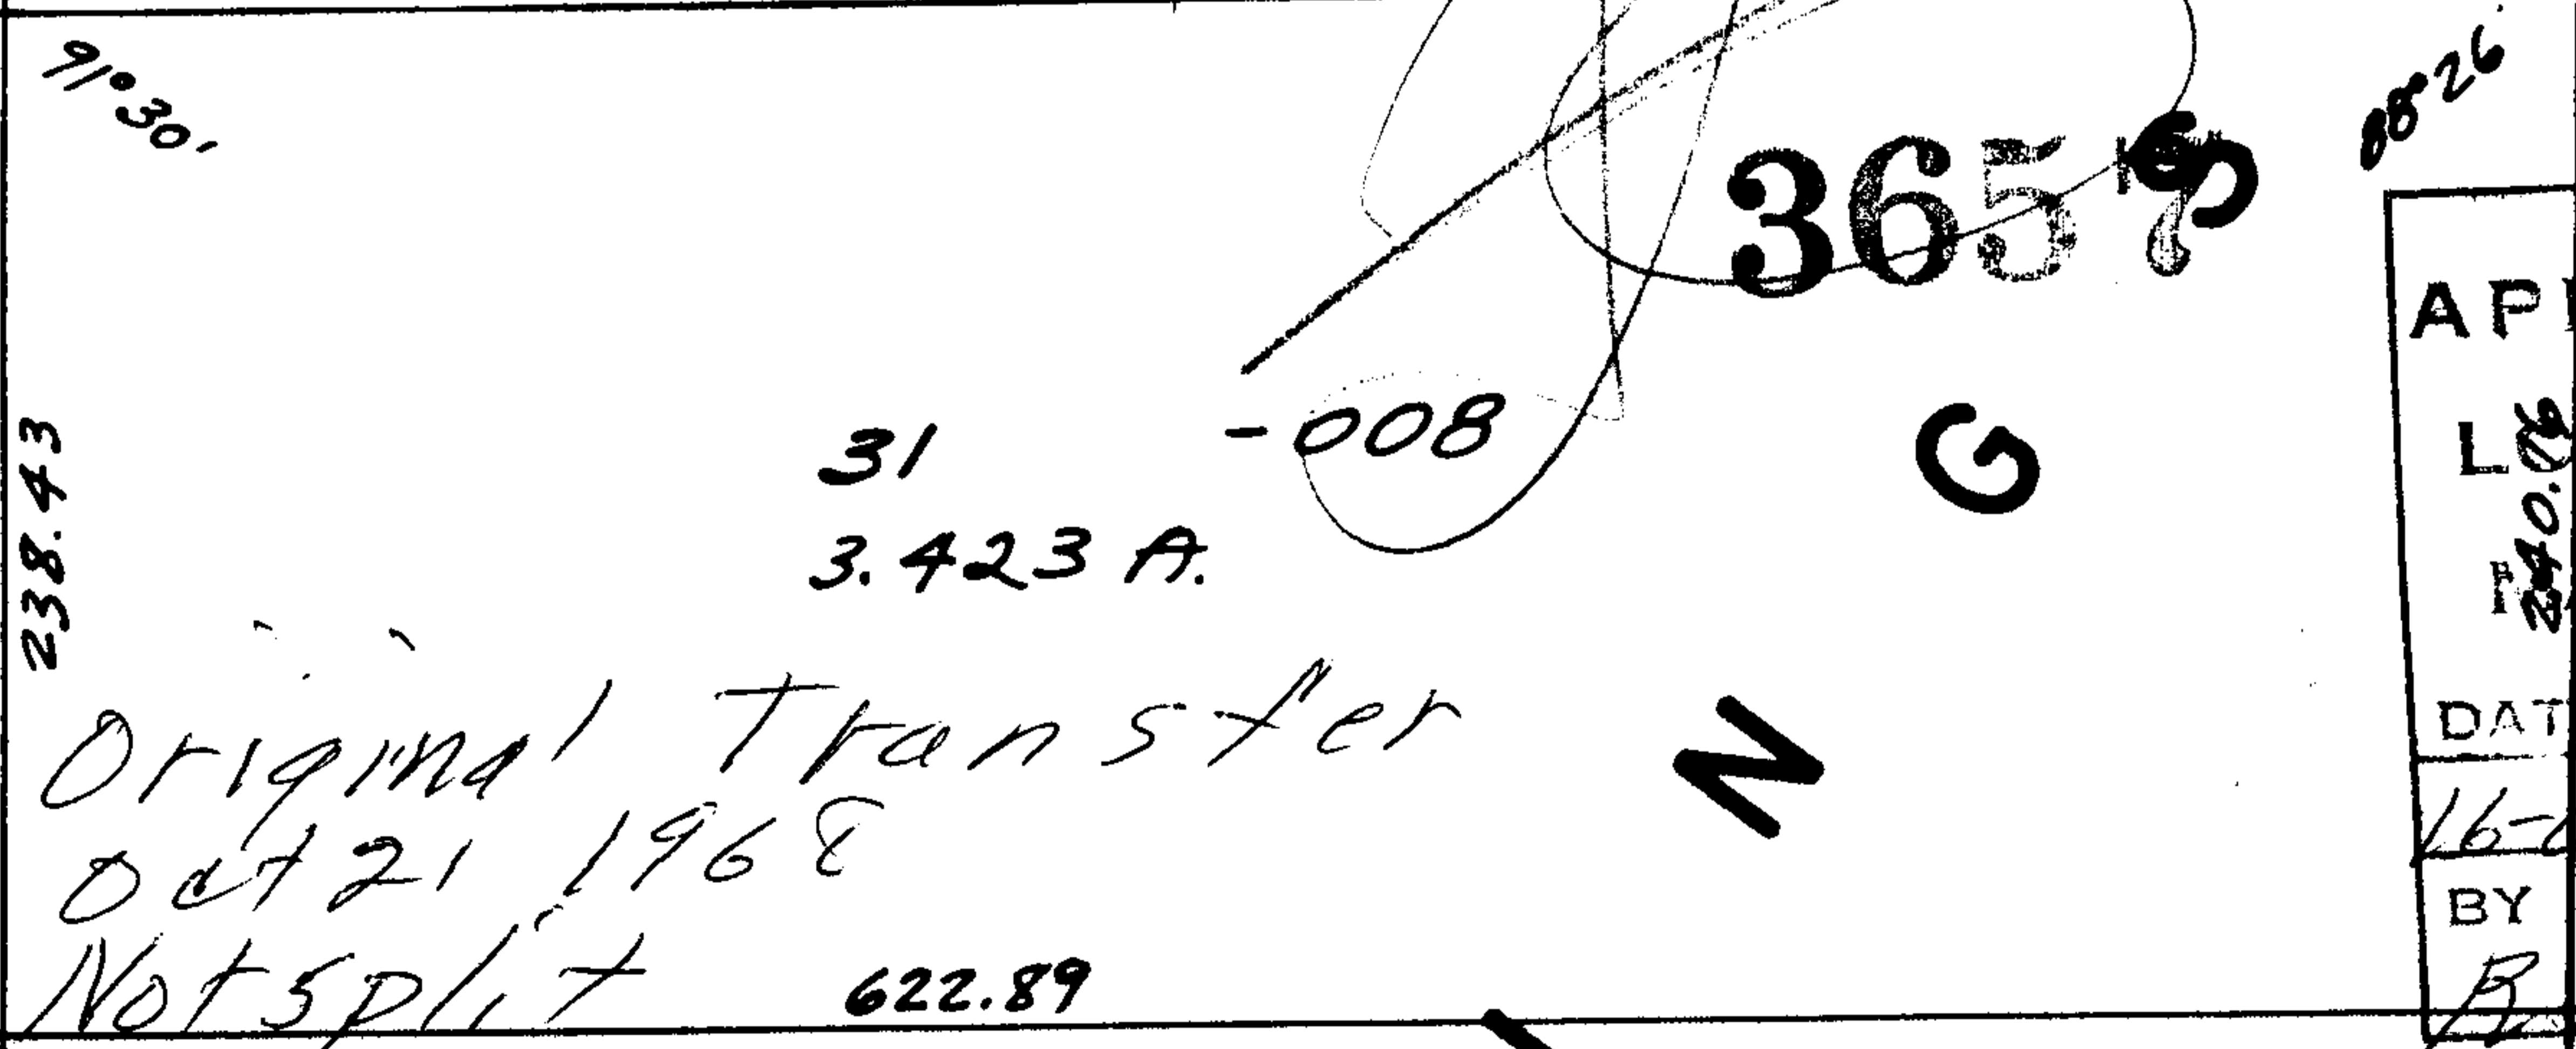
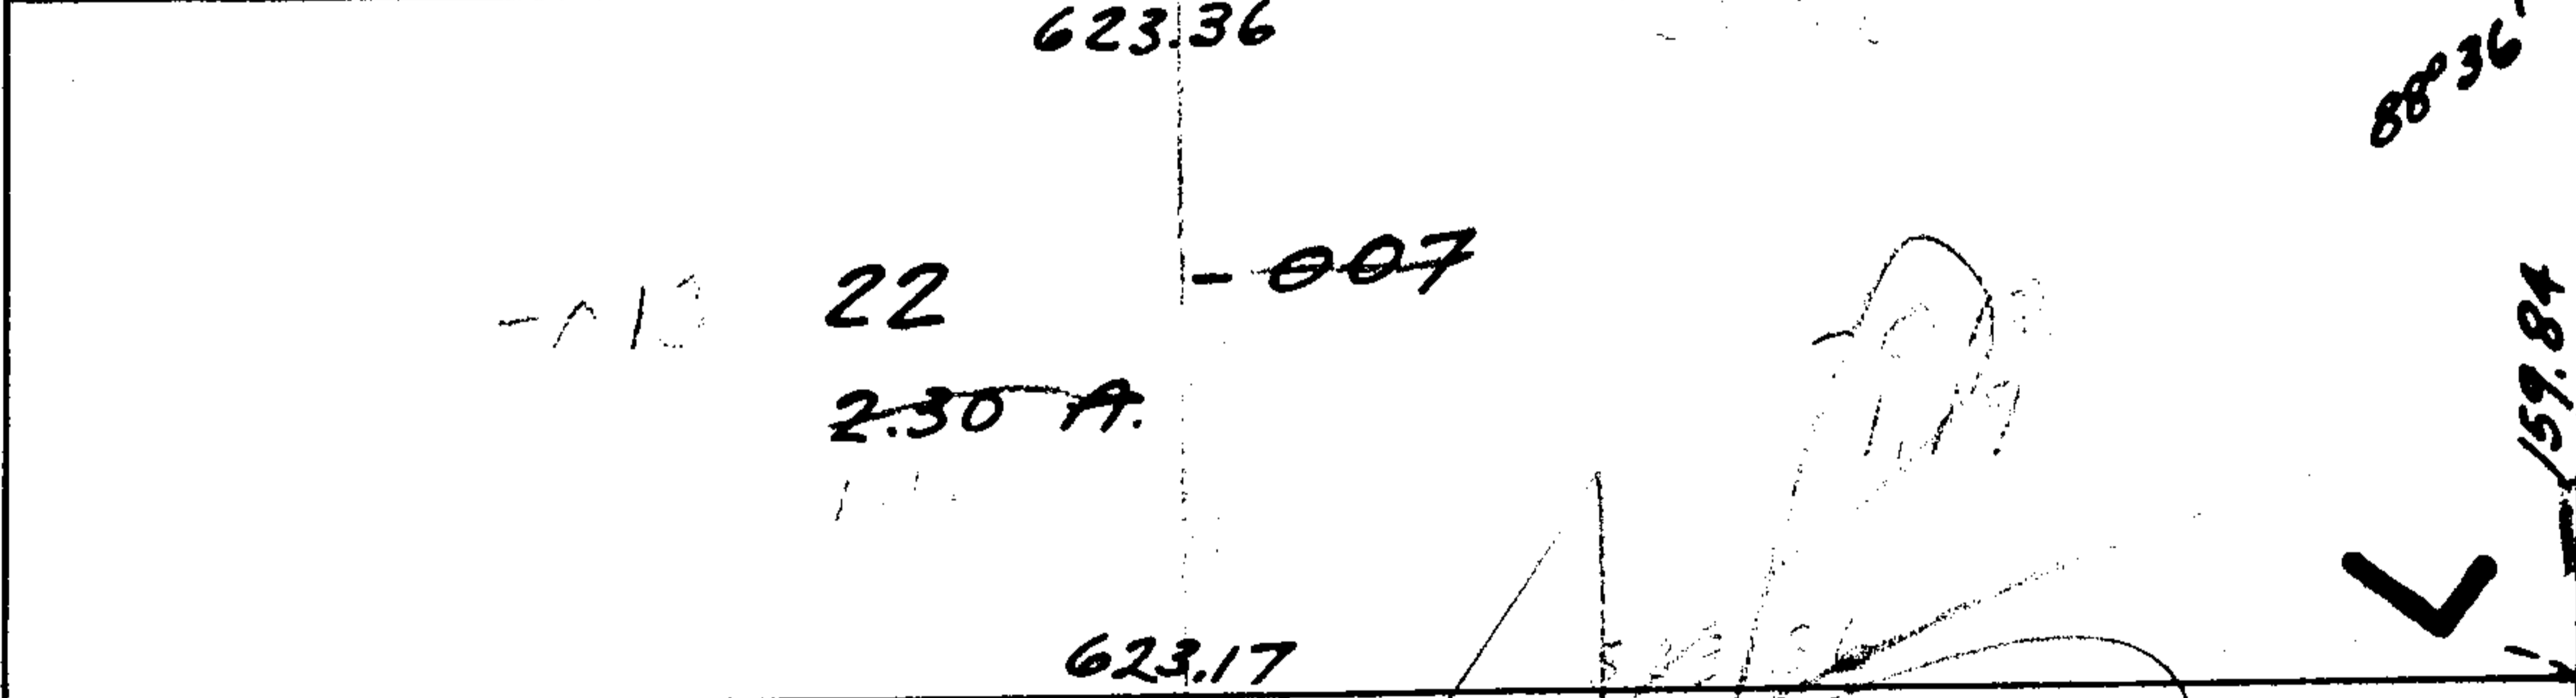


SEE 5-00 RD.

191.40 150 54.30 123.58 3657

191.56
300 **DELLWOOD**

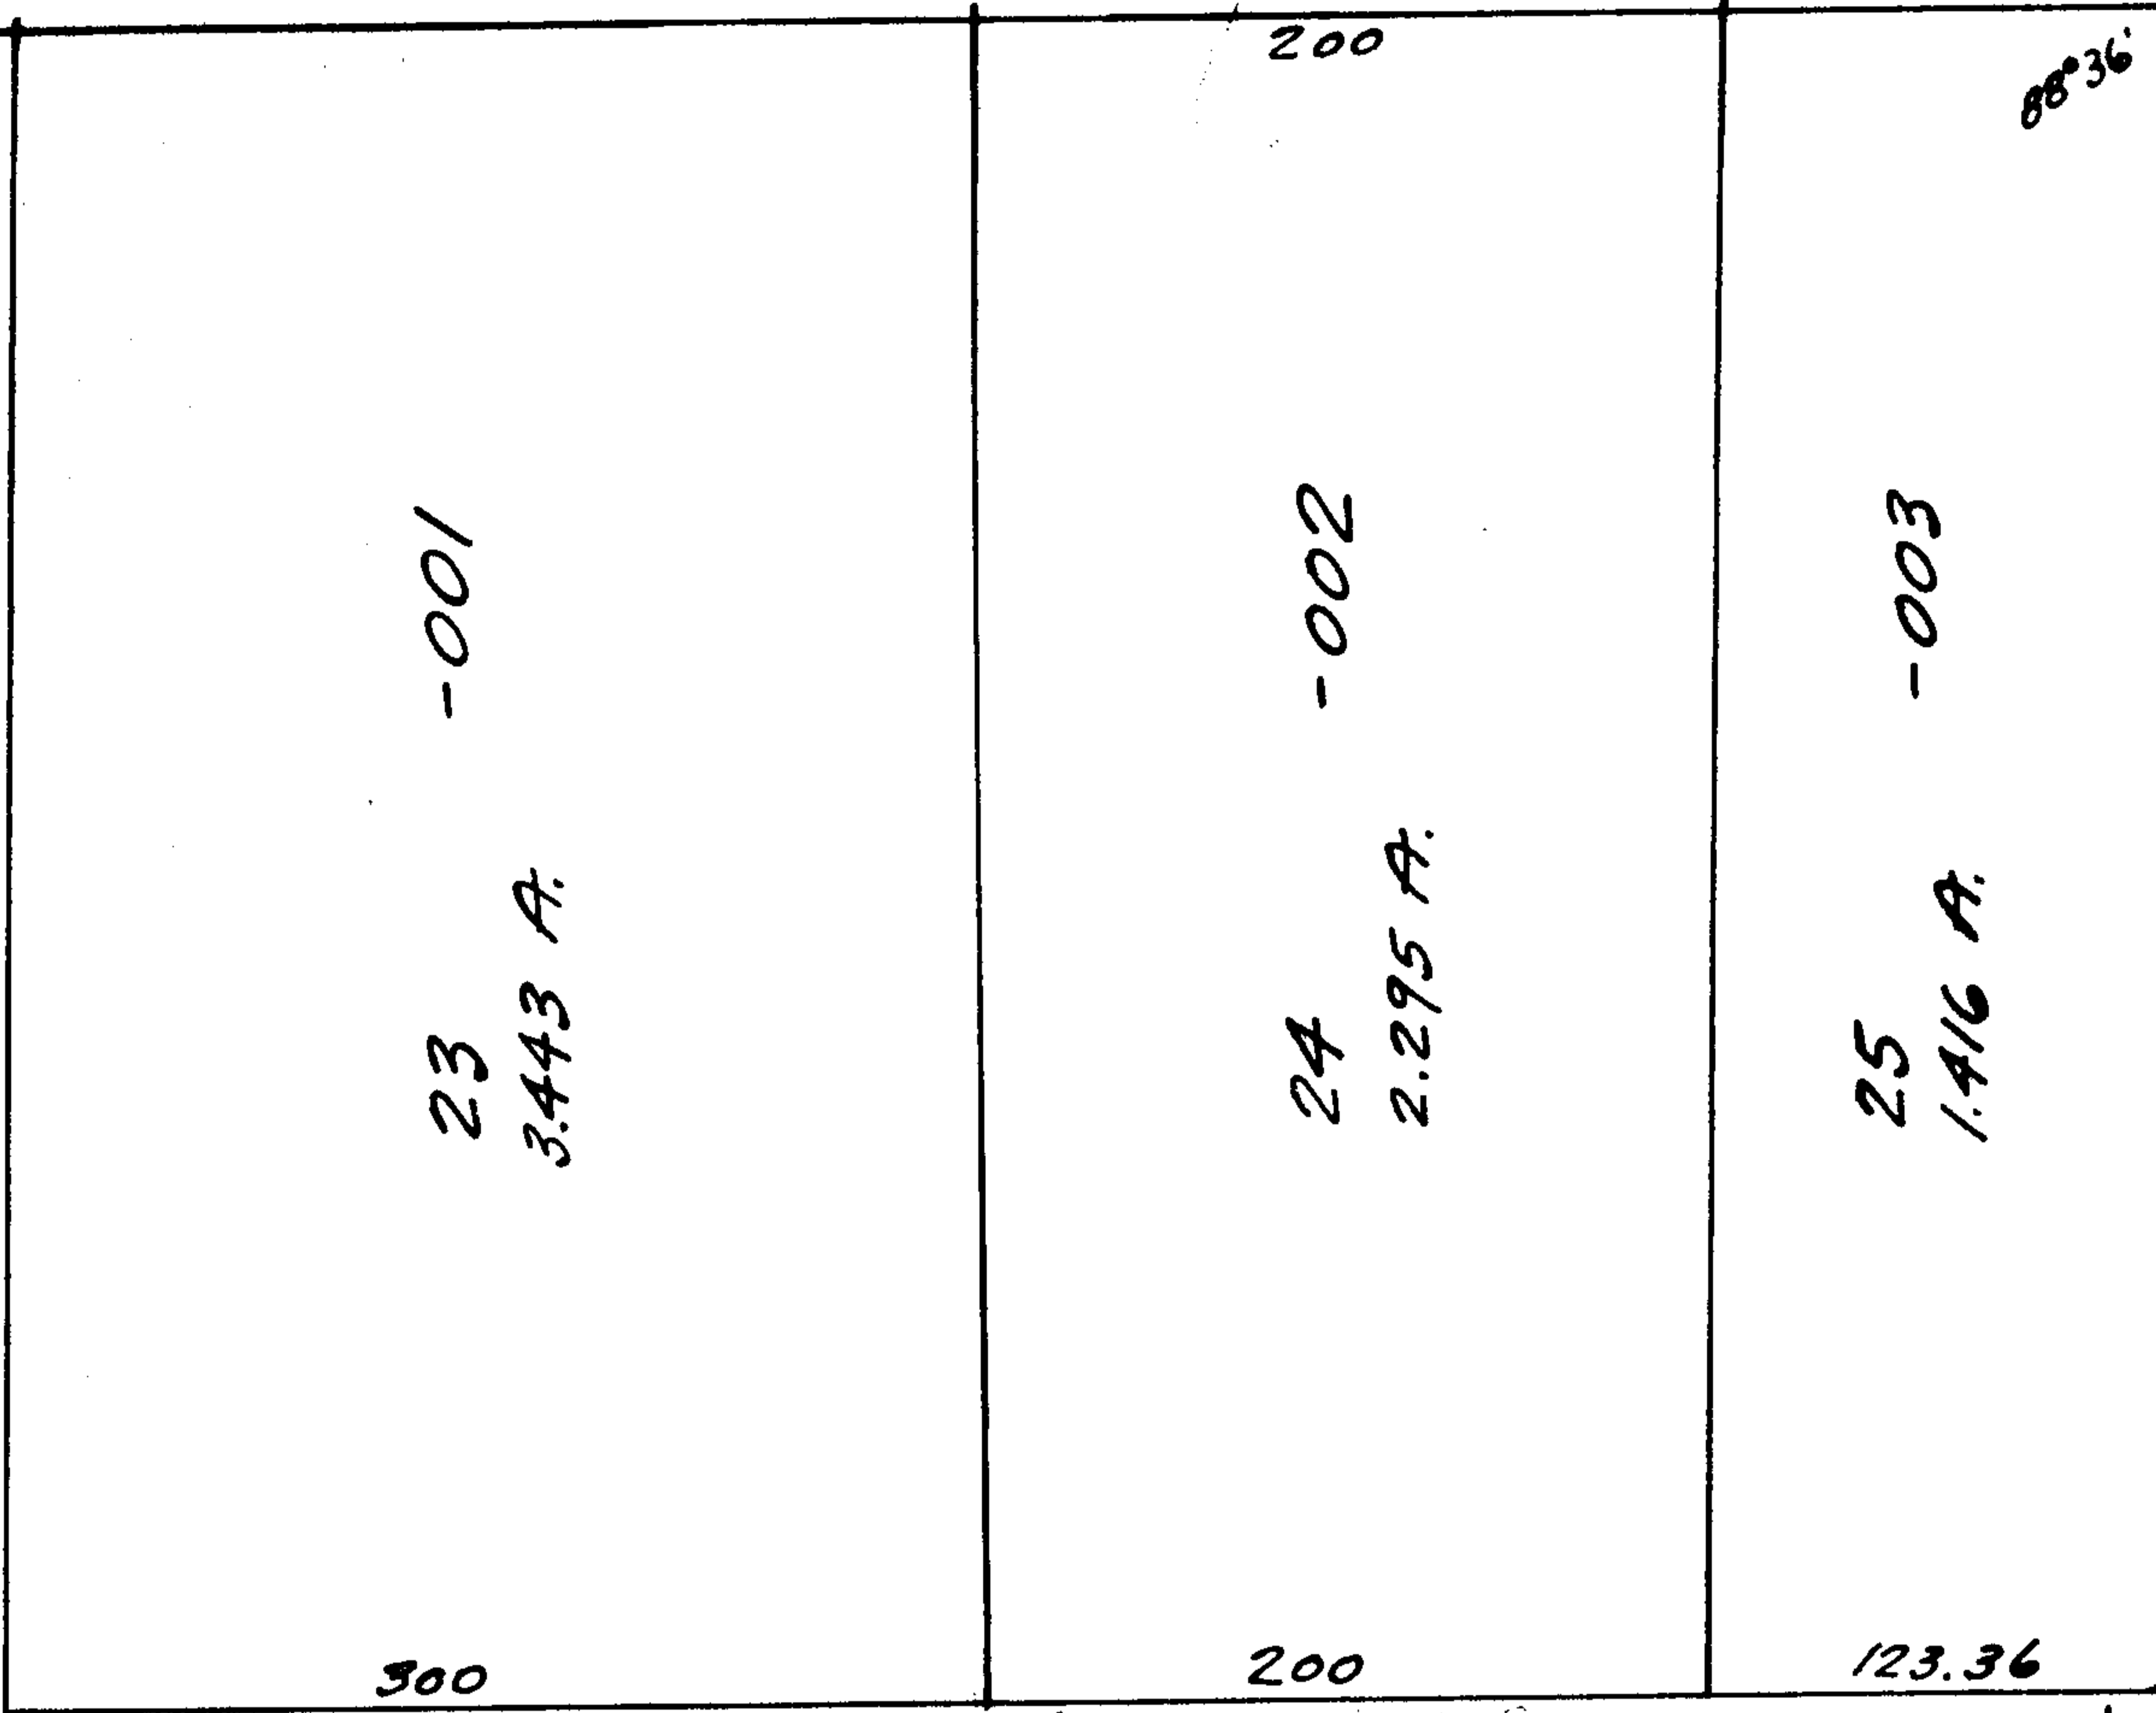

Original Transfer
Oct 21 1968
Not split

APPROVED
L RAIN CO.
MAP DEPT.
DATE: 4/12/70
16-00-075-B
BY: B. L. Kelliey

10