


114


Blair

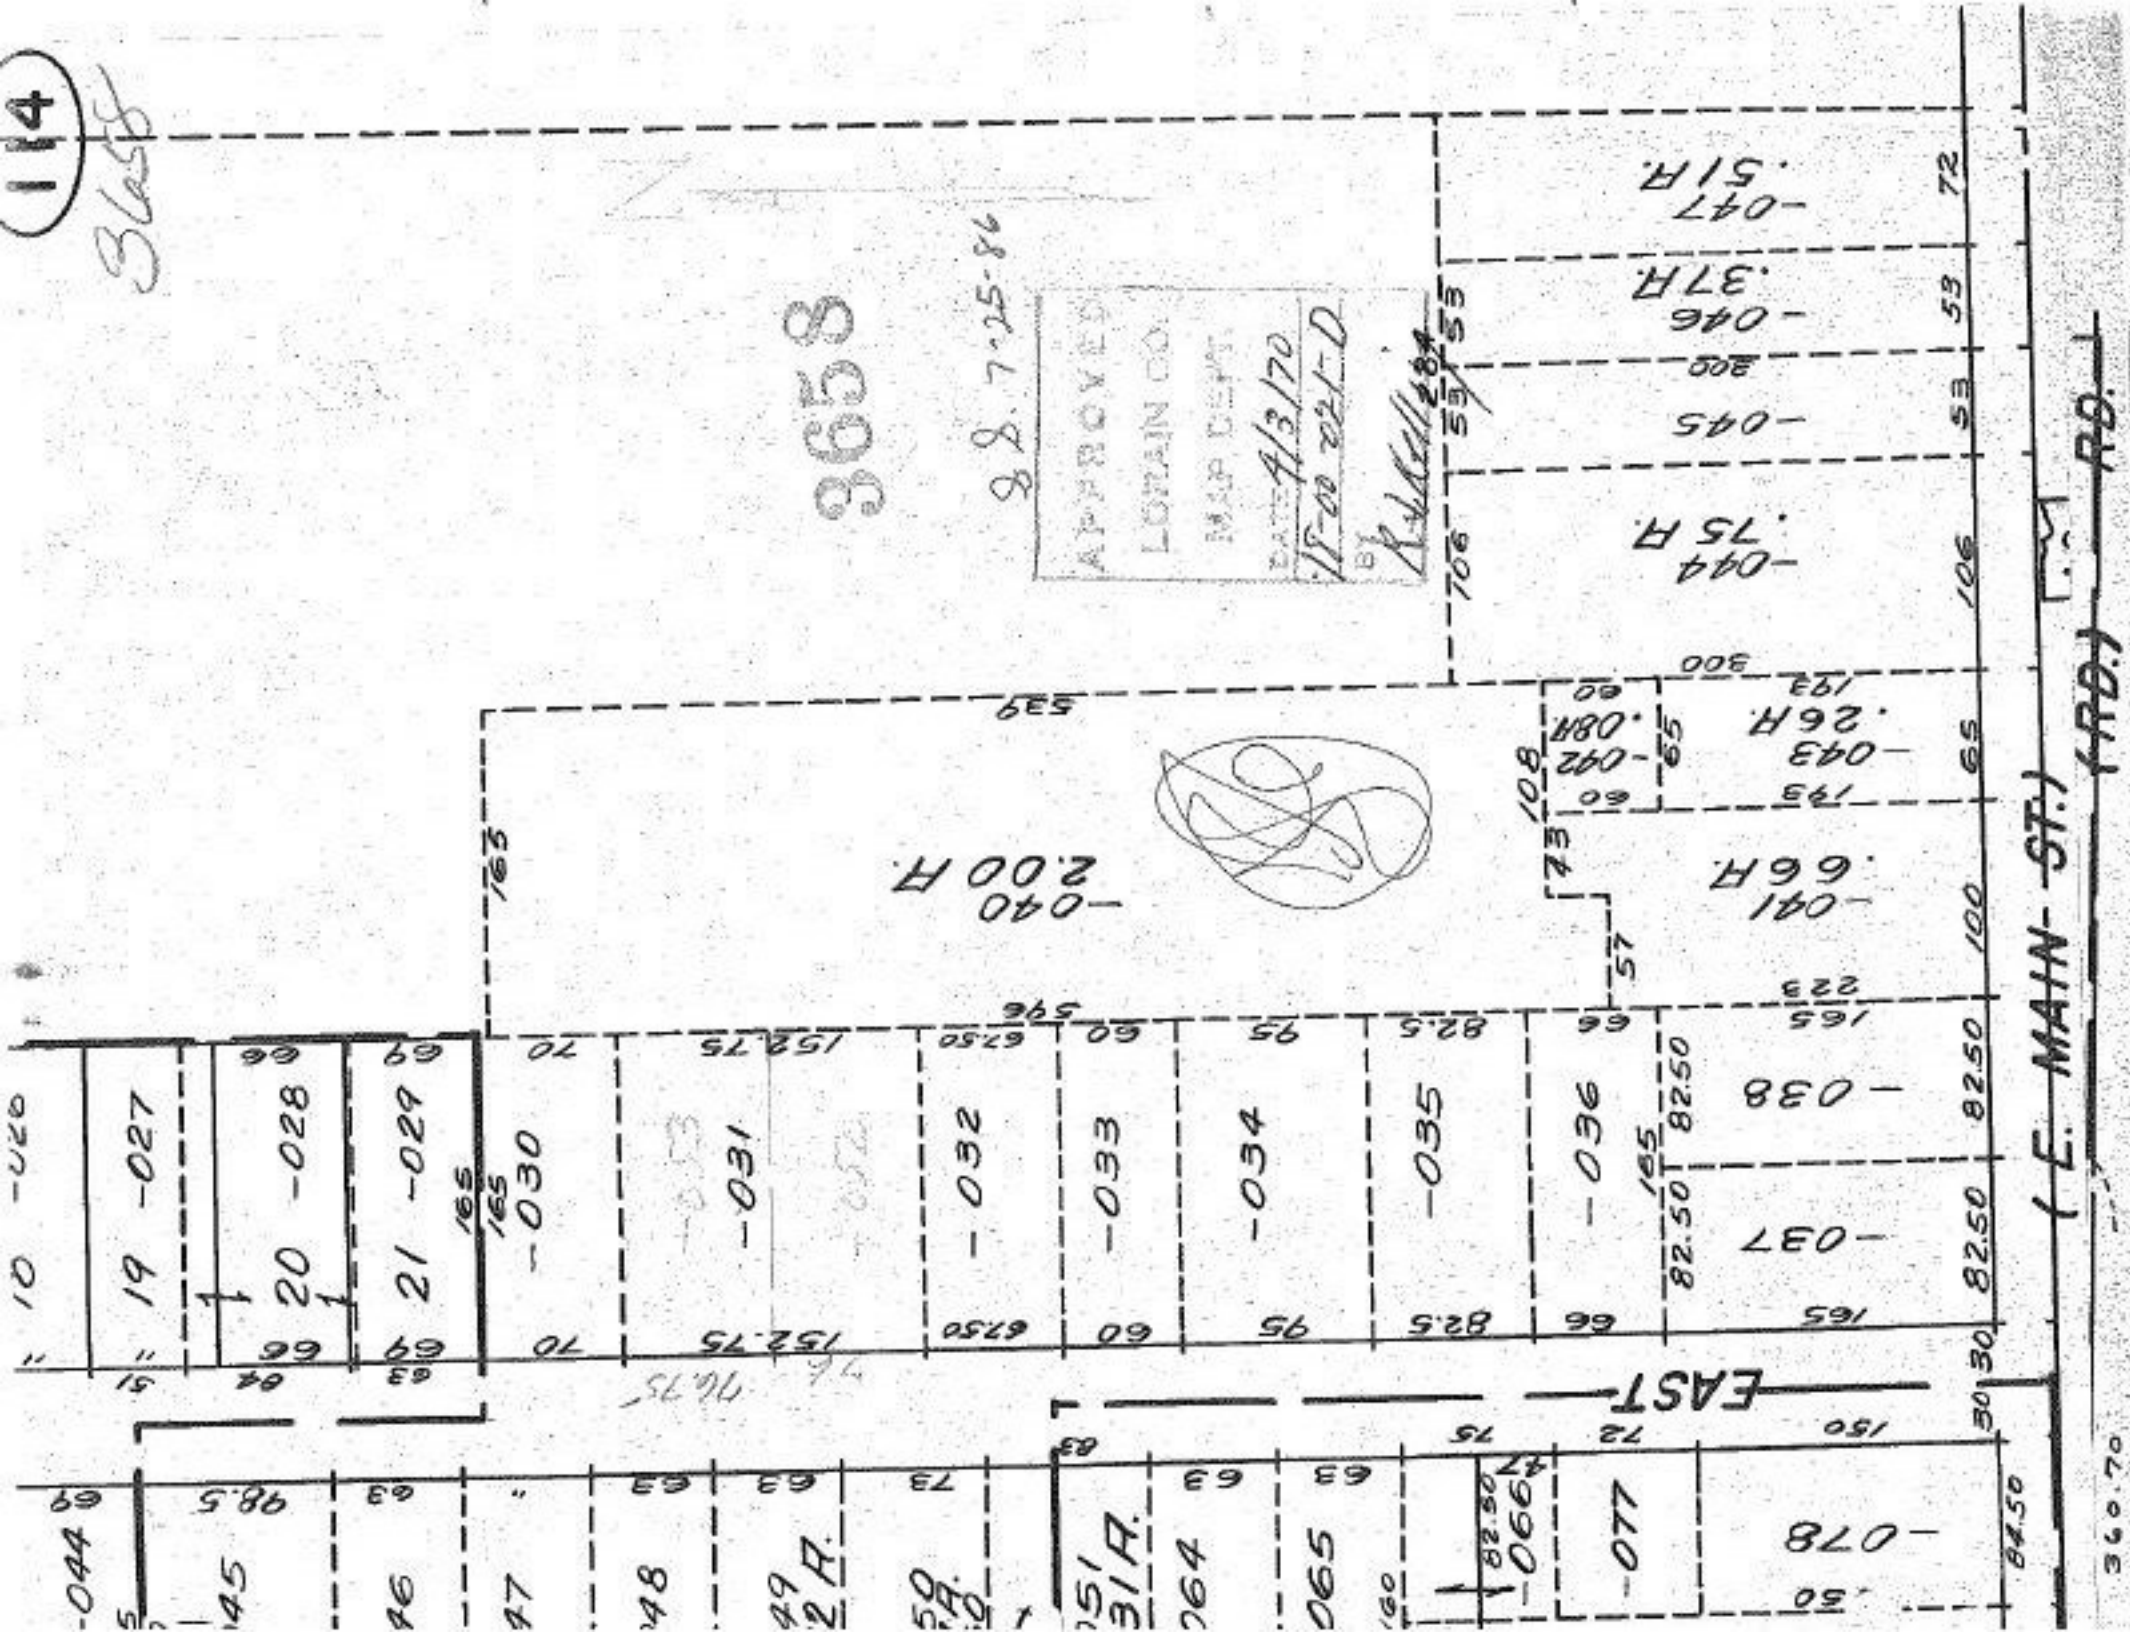

82.7-25-86

3658

APPROVED
LORAIN CO.
MAP DEPT.
DATE 4/3/70
BY R. H. KELLER

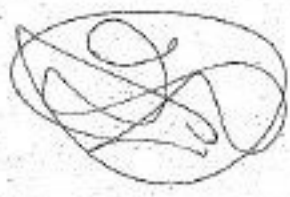

2.00 A.

(E. MAIN-ST.) (RD.)

360.70