

3671

3551.30

SEE

3668.7

189

150

-006
.65 A.
-003

189

150

1127.03

275

02-03-006-103-002

1.35 A.

316.80

275


4-8-70

02-03-007-000

-008

112,555 A total 647

103.50 A. Lot 7

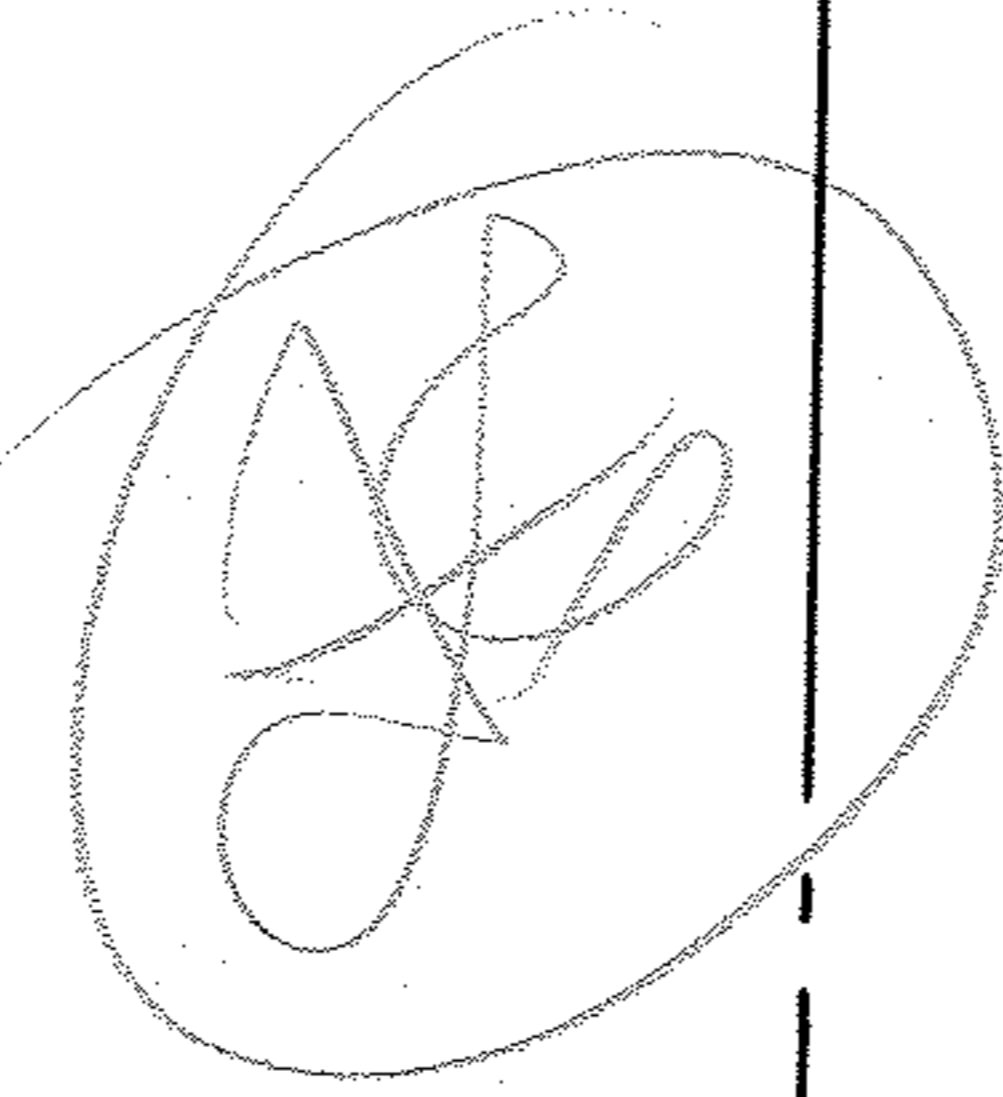

02-03-007-000-008

~~Pl. 02-03-007-000-007~~

P + Pl. 113.90 A. 112.55 A

9.05 A Lot 6

803.4

203.2

103

-001
0.85 A.

164.7

194.30

213.8

215.80

Done on Map 8-17-70 LWH

3671

MAY 4 ENT'D

APPROVED
LORAIN CO.
MAP DEPT.
DATE 4/7/70
BY R. J. Kelling

1002-190

113.90
112.55
1.35

103.50
9.05
112.55

OAK POINT 373.2

3677.3