


3603

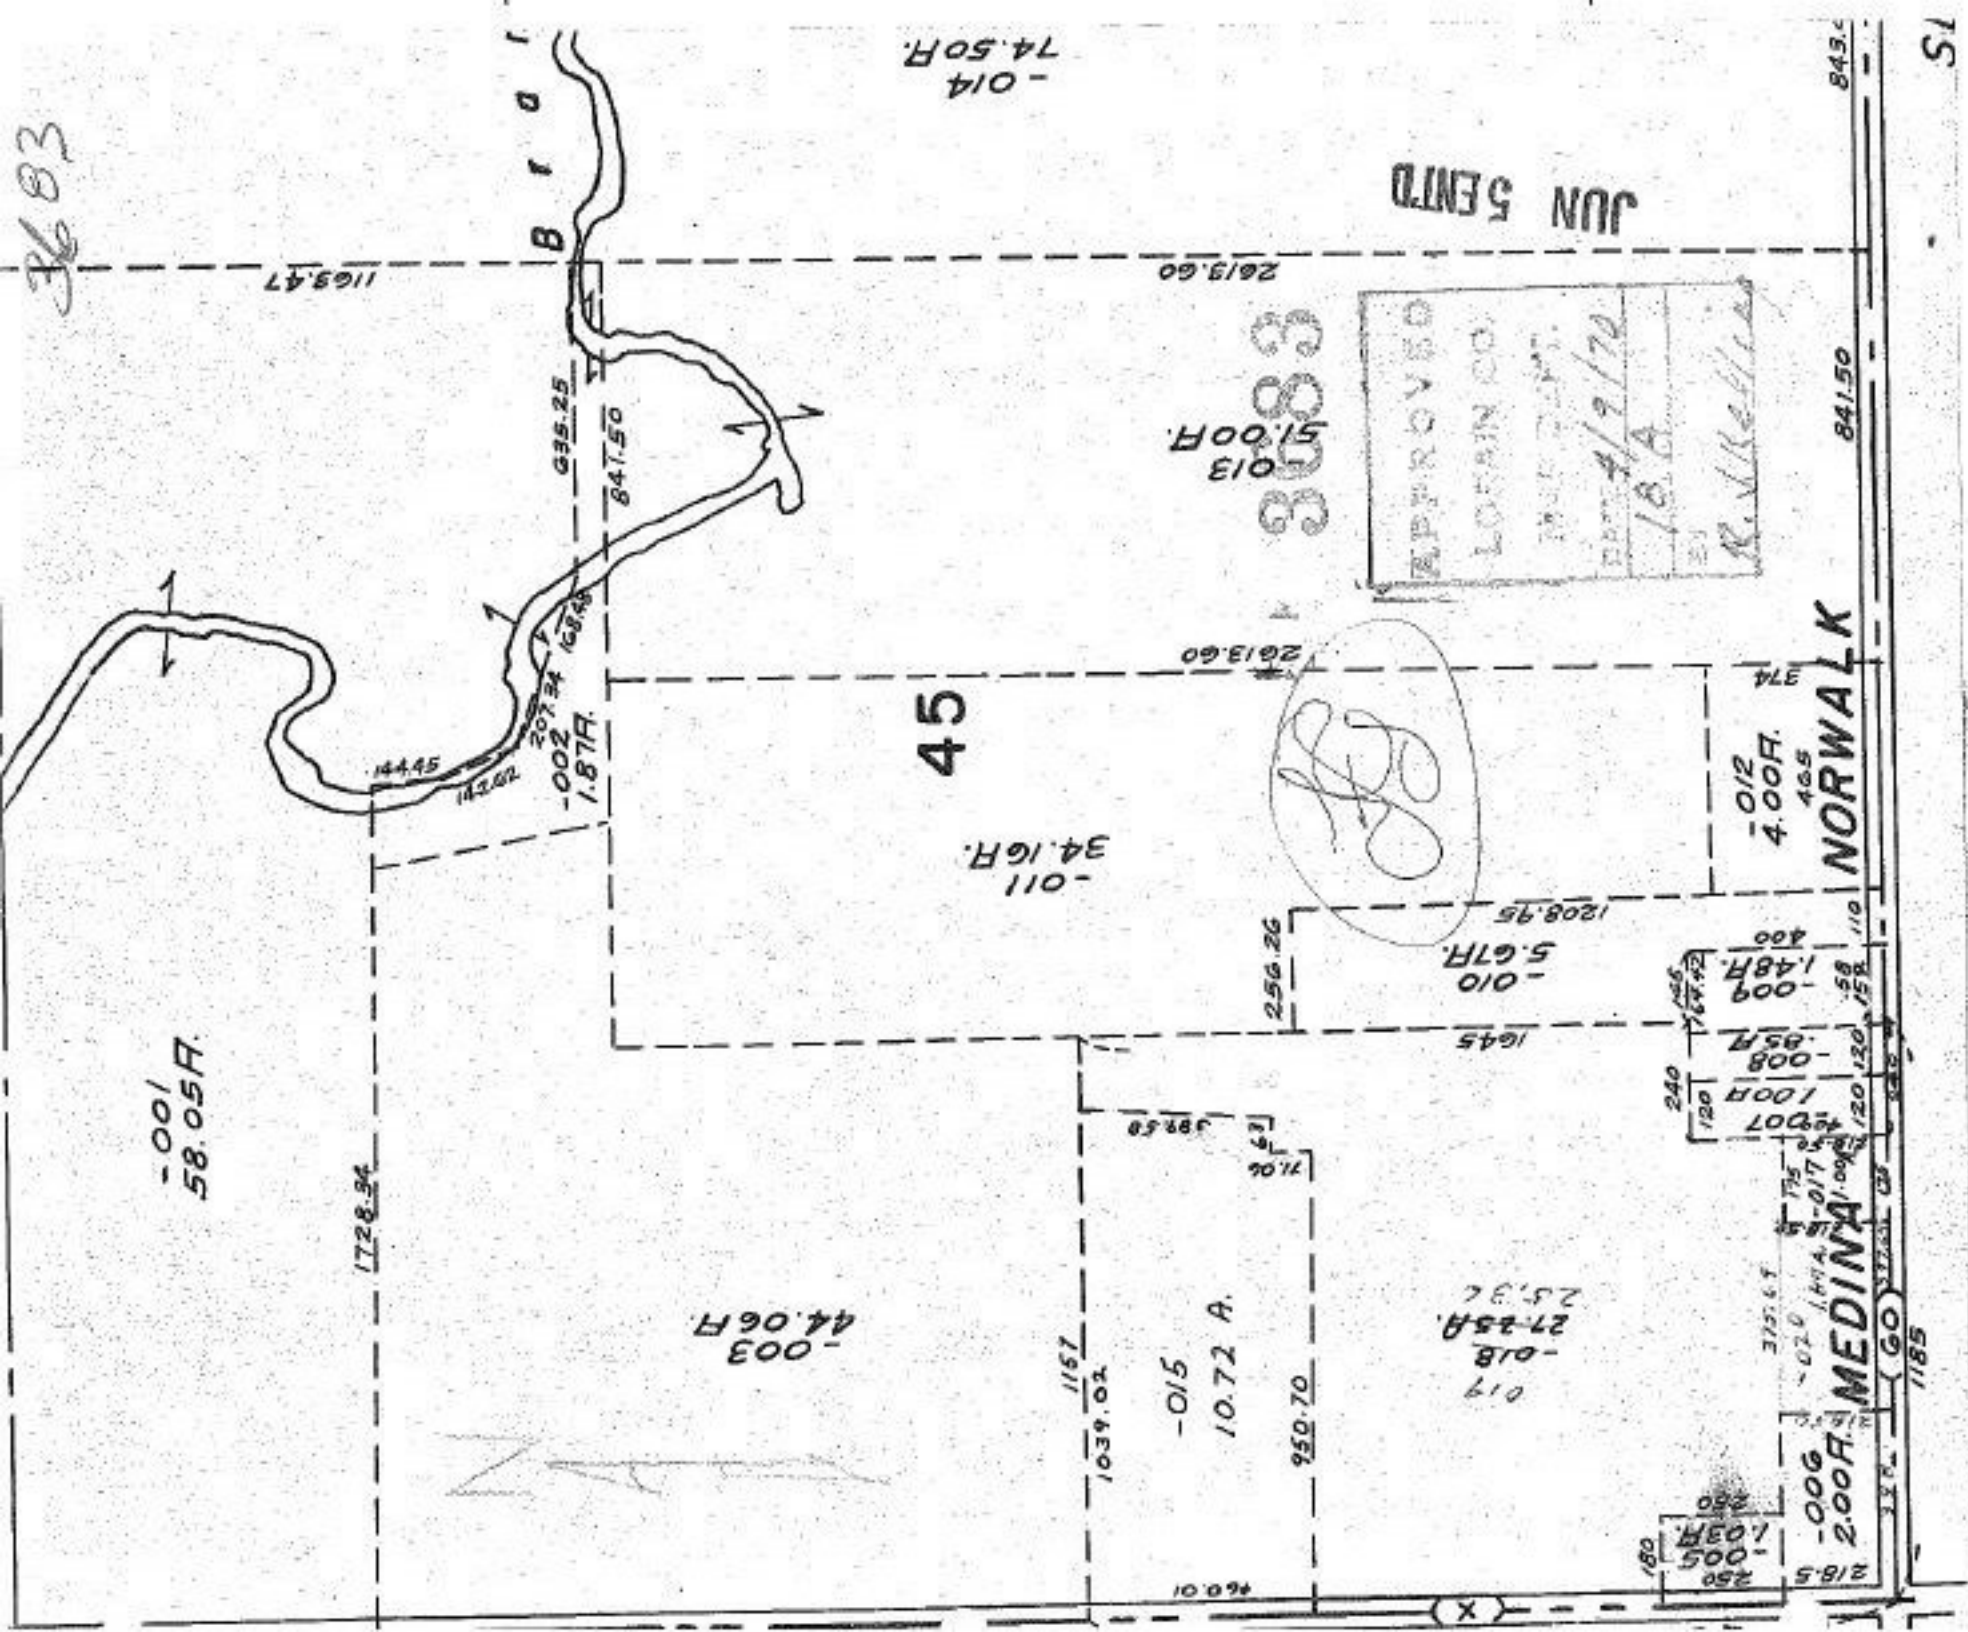

-001
58.05F.

1728.94

-003
44.06F.

45

-011
34.16F.

1039.02

-015
10.72 A.

950.70

019
-018
27.25A.
25.92

460.01

2613.60

51.00F.
013
3683

2613.60

256.26

-010
5.67F.

1645

1208.95

258
-005
1.03F.
250

-006
2.00F.

375.67

-017
1.49A.
1.75

120

120

APPROVED
 LORAIN CO.
 DIST. DEPT.
 DATE 4/9/70
 L.S.A.
 R. V. Medina

JUN 5 1970

NORWALK

-012
4.00F.
465

374

1185

1185

843.4

841.50

51

51

51

51

-014
74.50F.

1163.47

B r o i

695.25

841.50

142.62

207.34

163.78

1.87F.

144.45

142.62

142.62

