

RD.

ALBRECHT

1452.96

3703

APPROVED
 LORAIN CO.
 MAP DEPT.
 DATE 4/15/70
 10-A
 BY -037
[Signature]


Move over

049
 047
 48-34 R.
 47.77

3703

2170

MAY 1 1970

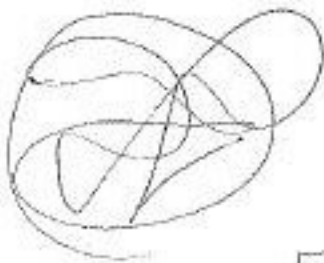

RD.

102

-002
 37.50A.

-003
 30.60A.

-010
 23.22A.

1510.34

-011
 22.00R.

R.R.

26277 184.72 19367
 203
 -005
 1.38A
 438.51
 -206
 2.00A
 460.22
 -007
 2.00A
 482
 -008
 3.00A
 512.64

RD.

RD.

311.43
 -027
 .50A
 298
 -026
 .48A

405.46
 -036 1.40A
 615.14
 -009 1.35A
 235
 -005
 .50A
 200
 -006
 .50A
 200
 -007
 .50A
 200
 -009
 .50A
 200
 -014
 .50A
 200

-010

2108 to 2901.24 to 11.07A.

-013

11.36A.
 2943

1735.80
 2736.34 + 6
 -015

1378A.

1736.46

1892.70 to 1336.50 to 2.500A.
 -017

-018

516.30
 -012 1.00A
 -013 1.00A
 -014 1.00A
 530.30

552