

#3712

337
66
401

1775
581

QUARRY

-001
66.45A

92

-003
40.61A - Dup #1
1.00A - Dup #2
41.61A - Total

238A

-007
~~-005~~
35.00A - Dup
35.25A - D.
3.163 2670


-006
25.00A

3712

JUN 5 ENT

APPROVED
LORAIN CO.
MAP DEPT.
DATE 4/12/70
9-E
BY P.V. Keating

SEE
9-15-70

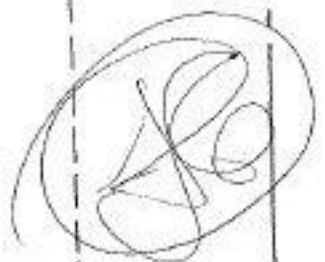

HAMILTON

(60) 1773.25 688

SEE INSERT ON MAP 9-F FOR LOTS 101, 102 AND 103