


3732

12-00-042-000-029
Pt. 14.35 A.

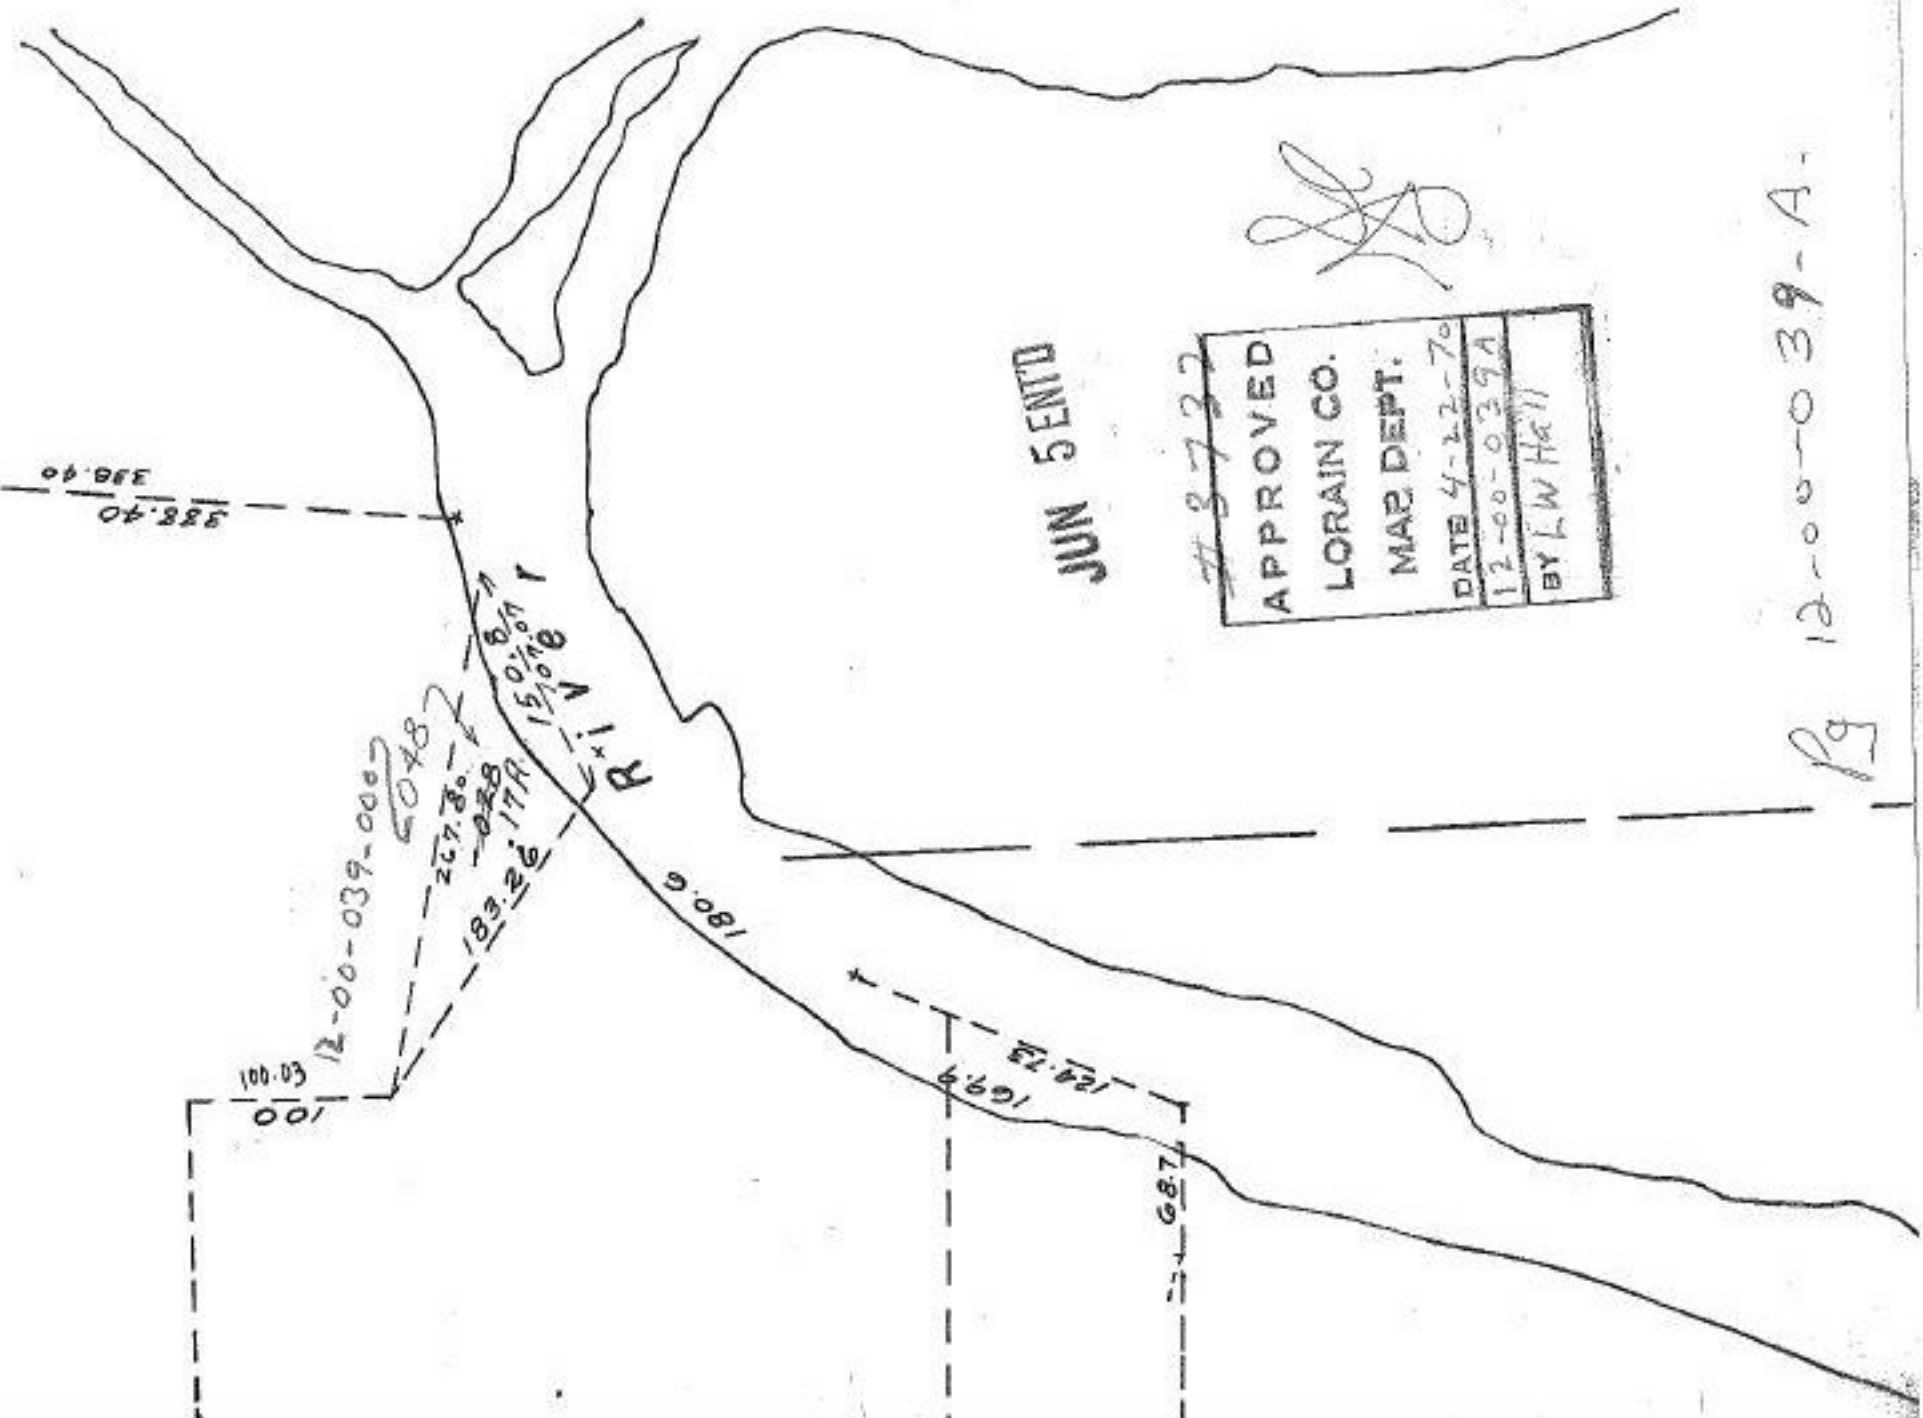

JUN 5 ENTD

3732

APPROVED
LORAIN CO.
MAE DEPT.
DATE 4-22-70
12-00-039A
BY L W Hall

[Signature]

Pg 12-00-039-A-