

3756

#3756
 APPROVED
 LORAIN CO.
 MAP DEPT.
 DATE 4-29-70
 H-00-026A
 BY L.W. Hall

150
 76
 226 AC

17,400 x 300 = 5,220,000 sq ft
 5,220,000 sq ft / 43,560 = 1,197.7 AC
 64-00-026-103-026

110 x 300 = 33,000 sq ft
 33,000 / 43,560 = 76
 30 x 200 = 24,000
 24,000 / 43,560 = 55.3 AC
 64-00-026-103-027

100 ft x 37
 37 x 85 = 3145
 3145 / 4356 = 72

right 1963

7-6-68

H-00-026A


Done on Maps 8-14-70

L.W.H.

See DW 595 Pg 563

Done on Maps 8-14-70

AVON VILL

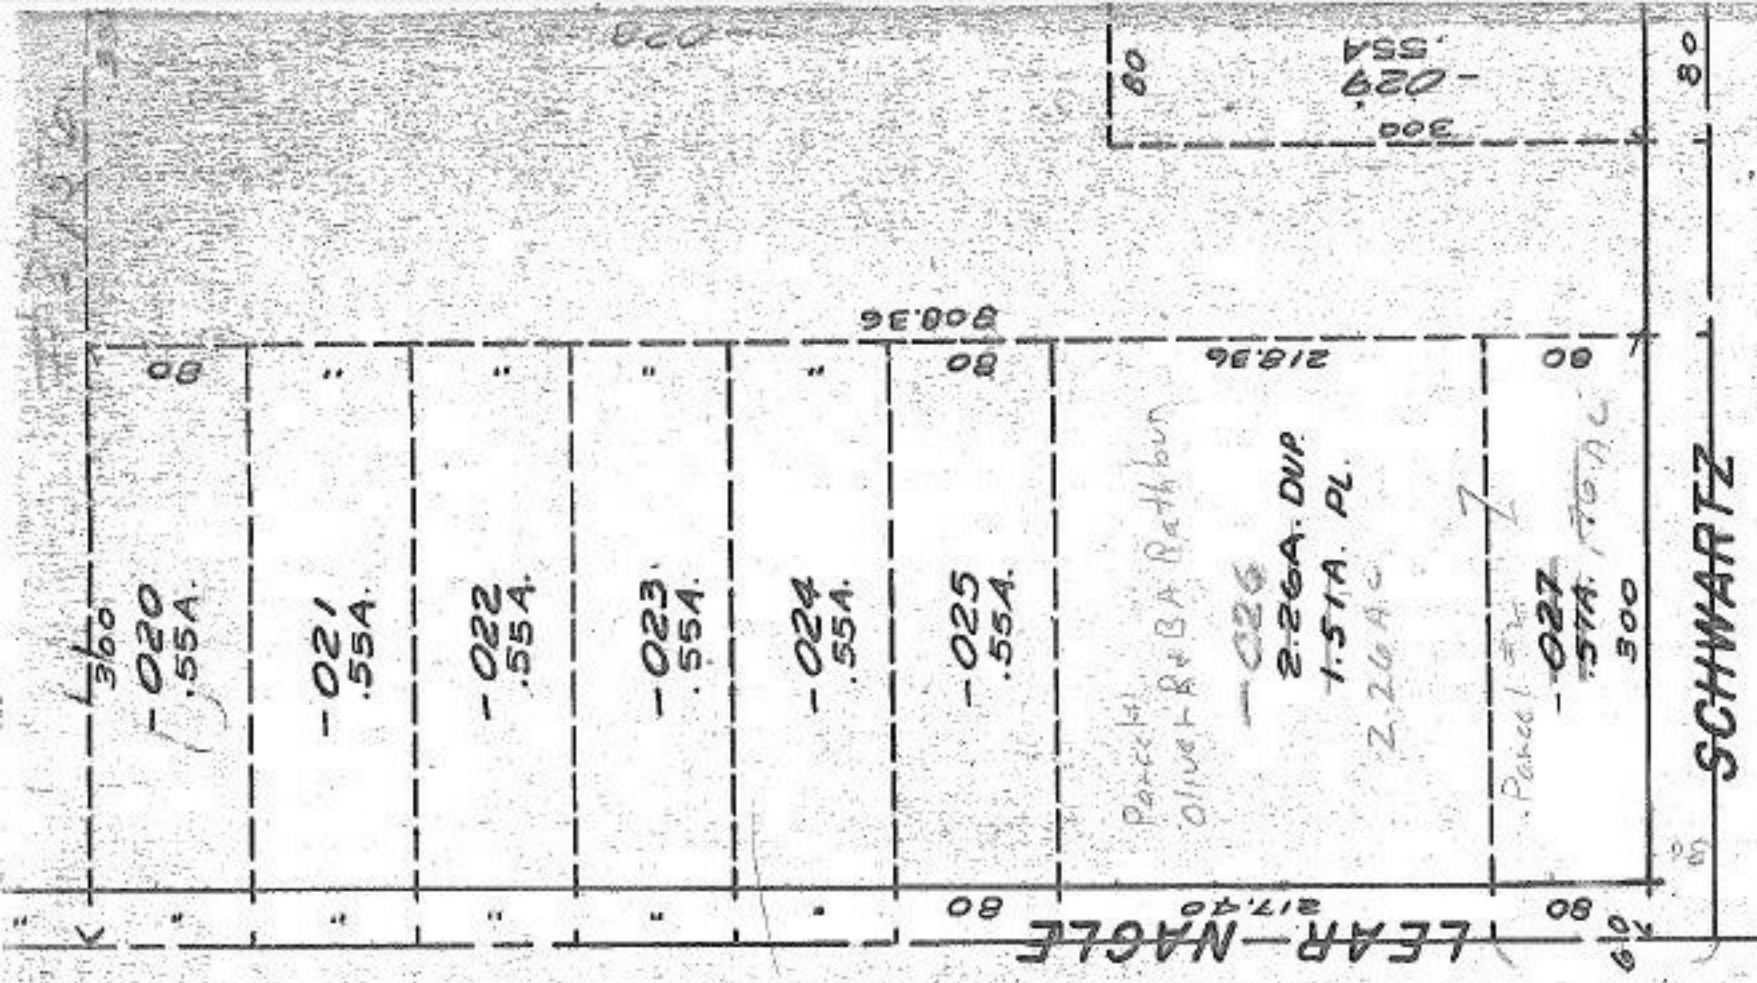

SCHWARTZ

LEAR NAGLE