




3777

514.83

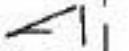


-058
2.88A.

244.77

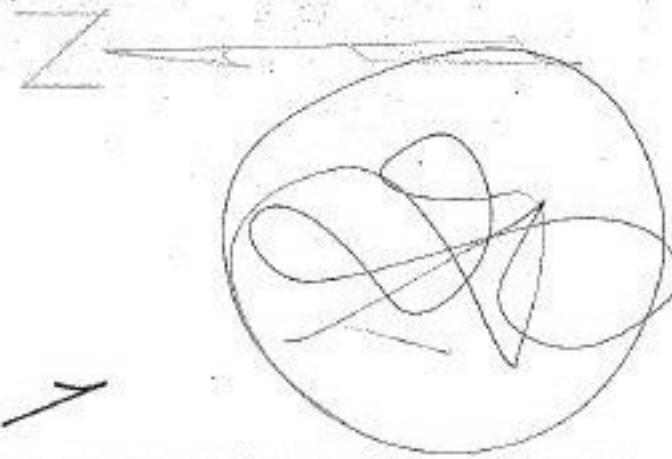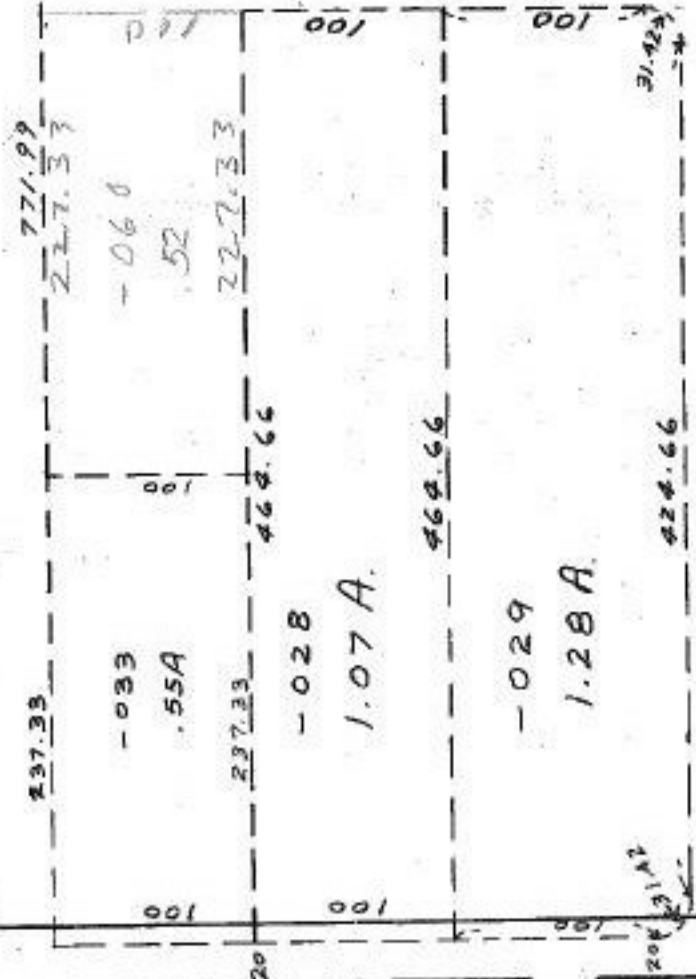

-061
-059

15.44A.
14.92

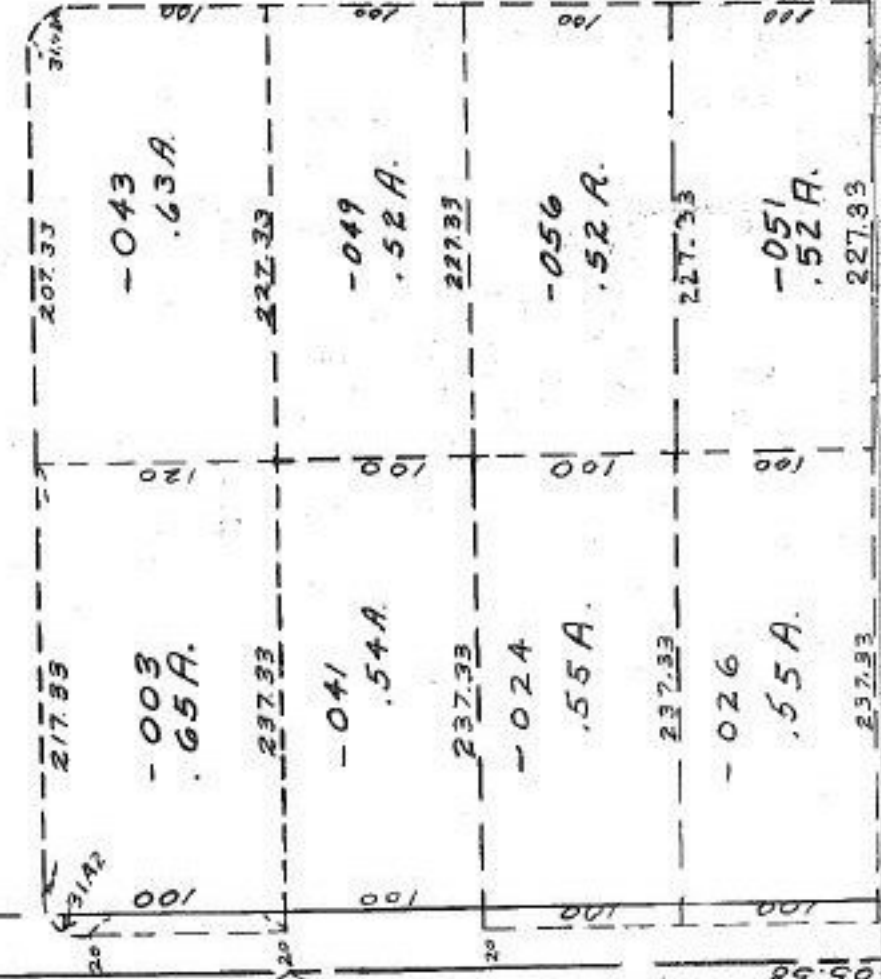

3777

JUN 19 1970

APPROVED
LORAIN CO.
MAP DEPT.
DATE 5/6/70
12-00-015-A
BY R. Keeling

S. D.
7-31-86

05.58