


MIDDLE RIDGE

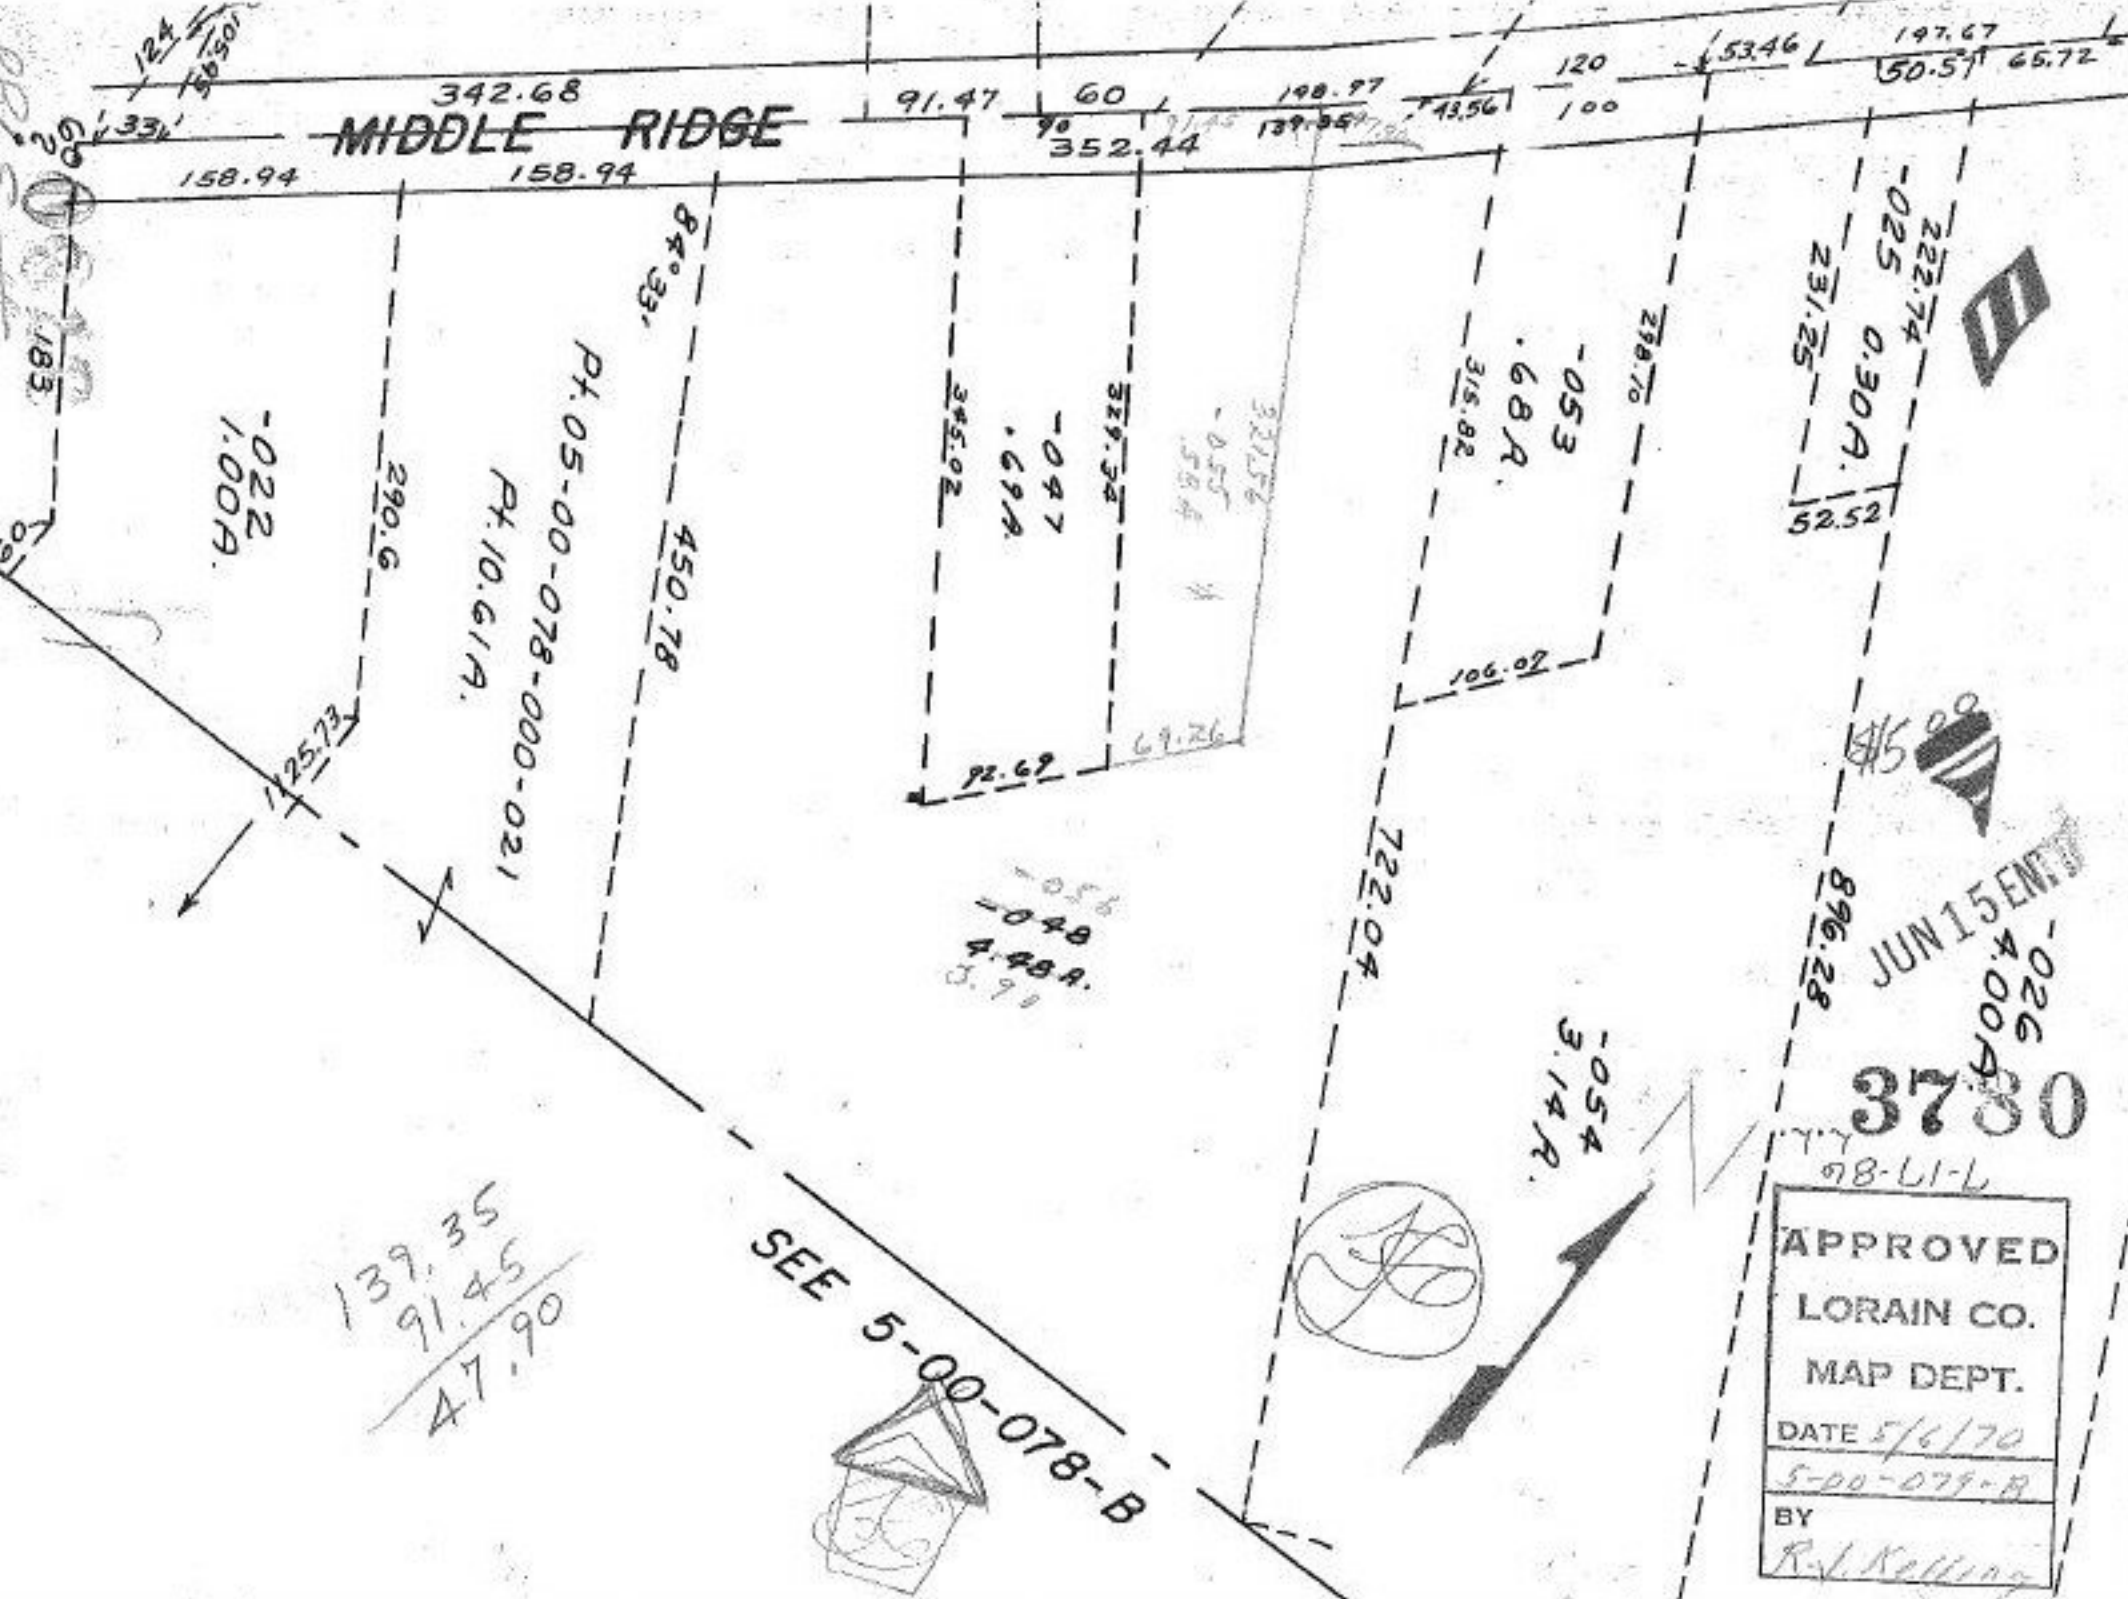

124
105.95
33
183
09

139.35
91.45
47.90

SEE 5-00-078-B



APPROVED
LORAIN CO.
MAP DEPT.
DATE 5/6/70
5-00-078-B
BY
R. J. Kelling

JUN 15 ENT

3780

