
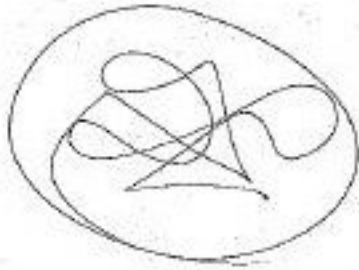


Total Area .6673
 Sub Lots .5613
 Area .106

3785

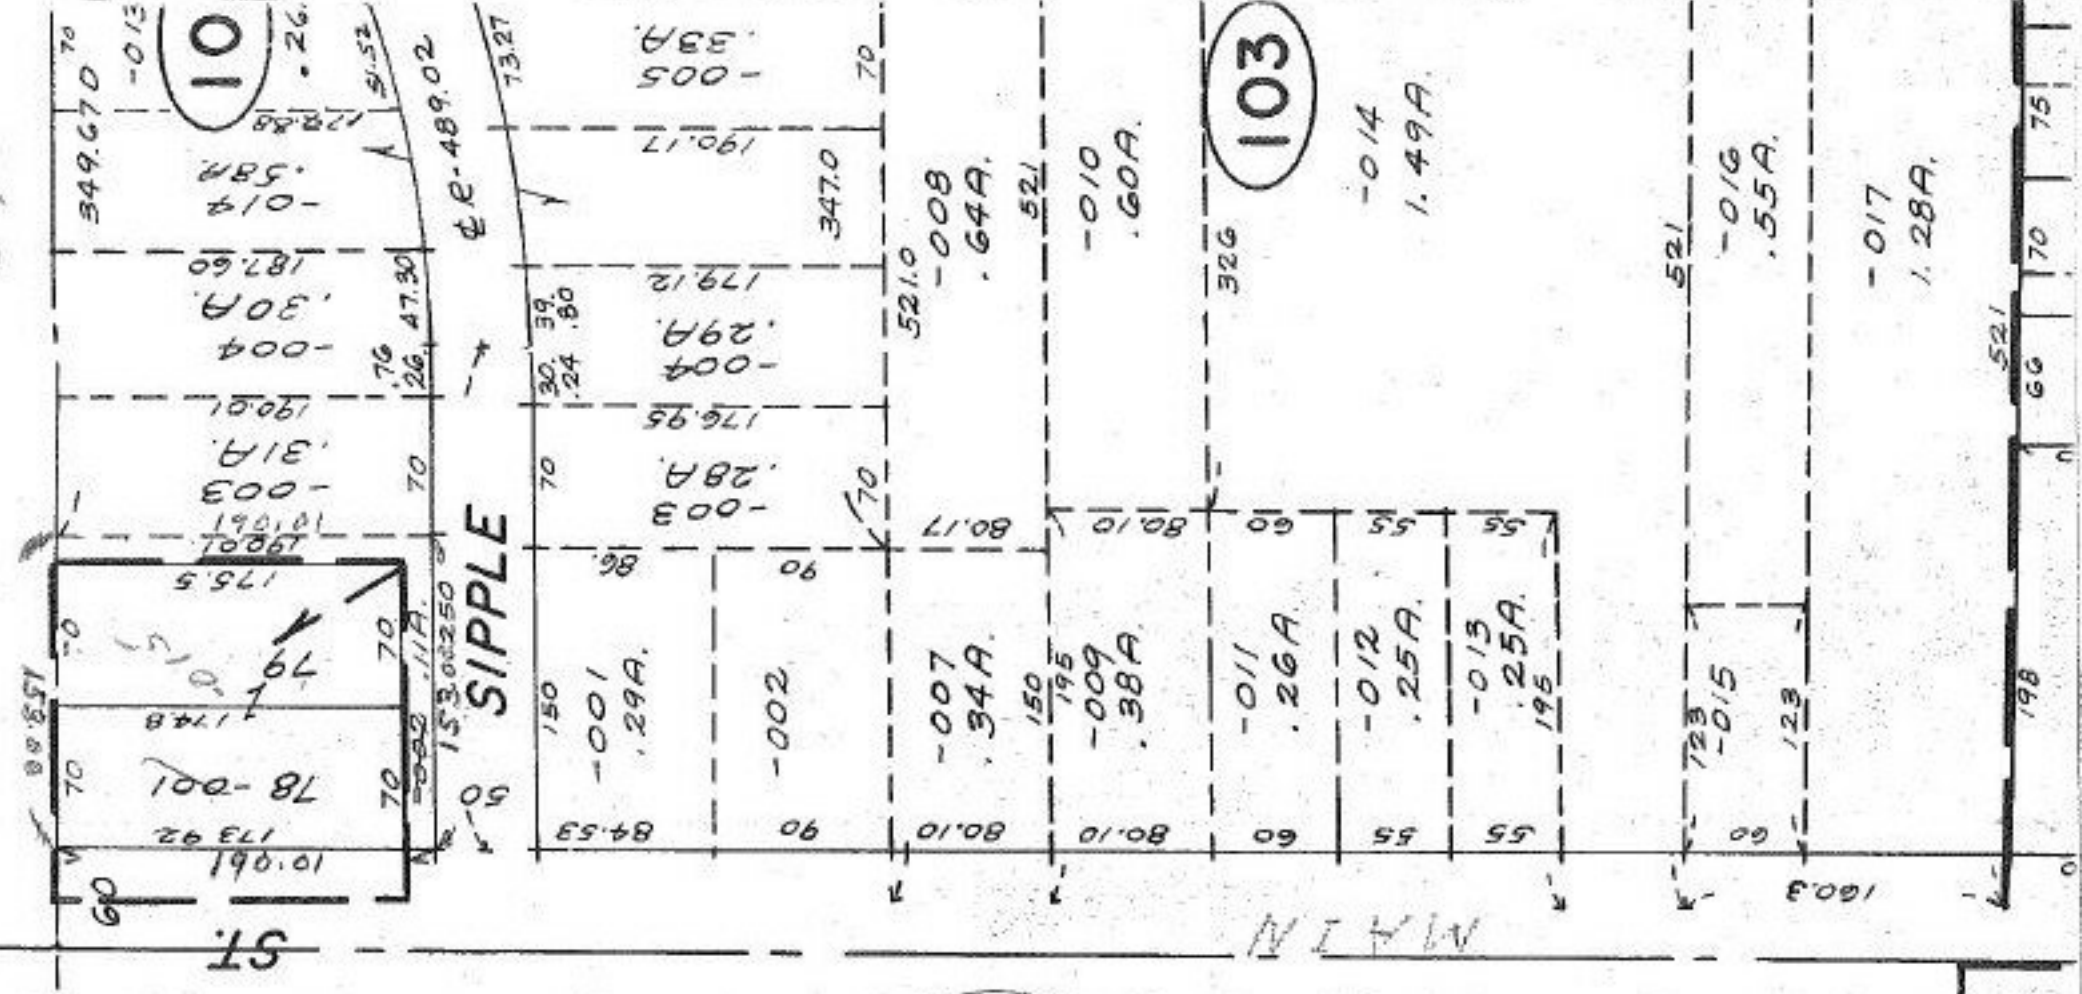

JUN 15 1970

3785

APPROVED

LORAIN CO.

MAP DEPT.

DATE 5-7-70

500-023A

BY L. W. HAI

7-16-86 L.I.

5-00-023A

B