

3811
3811

497

508.20

10.4
1.3
8.3



322.9

-030
1.48 A.

-037
7.85 A.
JUN 19 1980




-015
1.71 A.

304.97

7-23-86

APPROVED
LORAIN CO.
MAP DEPT.
DATE 5/13/76
BY R. L. Keating

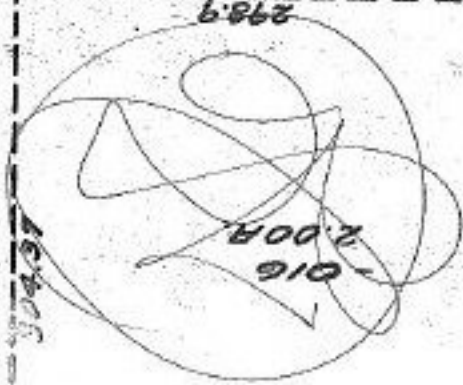

298.9

180
157° N 0° 13' E

266.78

168.30

1-017

2-018

3-019

A N
BKH-020

4 N
N-021

10 V.16
-022

80

80

90

60

90

80

270.60

5.87° 50' W

SEE 11-00-100-B