

02

60

RD


RD

150  
 100  
 50  
 00  
 100  
 150  
 200  
150  
 100  
 50  
 00  
 100  
 150  
 200  
76

RD

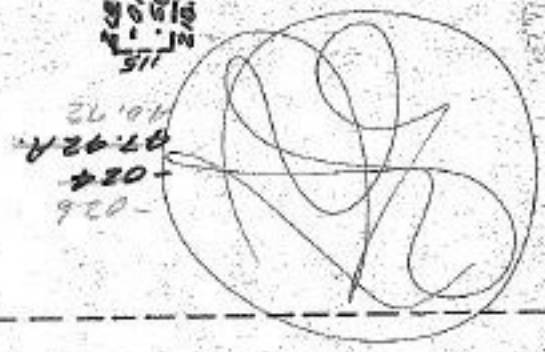

38.50 A.  
 -005  
**85**

-004  
 27.44 A.

-002  
 3597.19  
 12.18 A.

-001  
 40.80 A.

3584.89

115  
 100  
 85  
 70  
 55  
 40  
 25  
 10

300  
 -017  
 1.51 A.

300  
 -023  
 .97 A.

217.8  
 2.93 A  
 610  
 528.50  
 -01  
 1.21 A.

APPROVED  
 LORAINICO.  
 MAP DEPT.  
 DATE 5/13/70  
 JFE  
 BY R. Kelling

P. P. 31-86  
 7-3-86

3832

217.87

528.28

100

100

