



SEE 9 F

3865

RD.

60

ST. 258.24

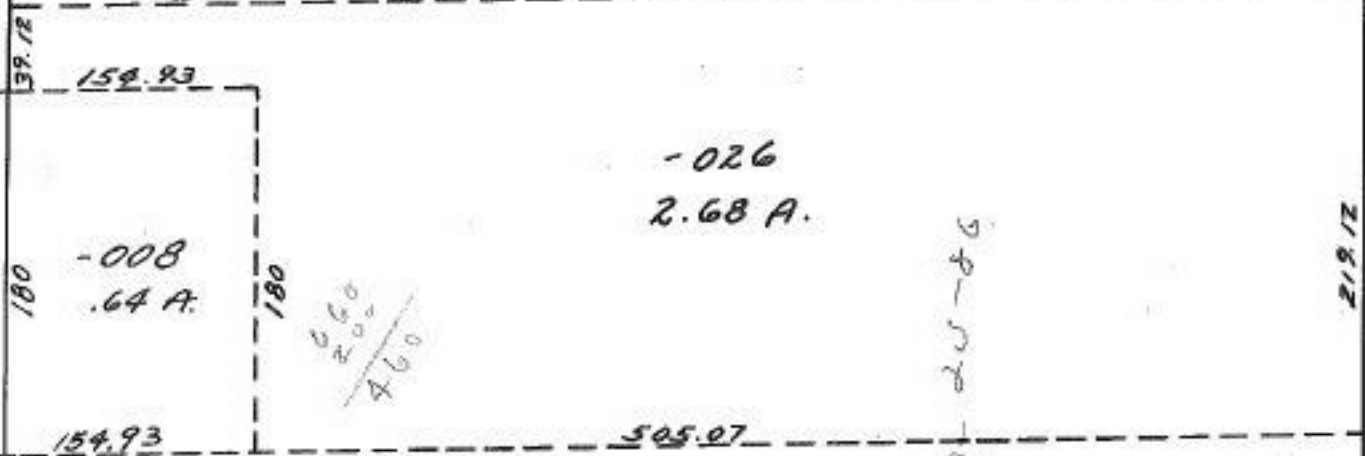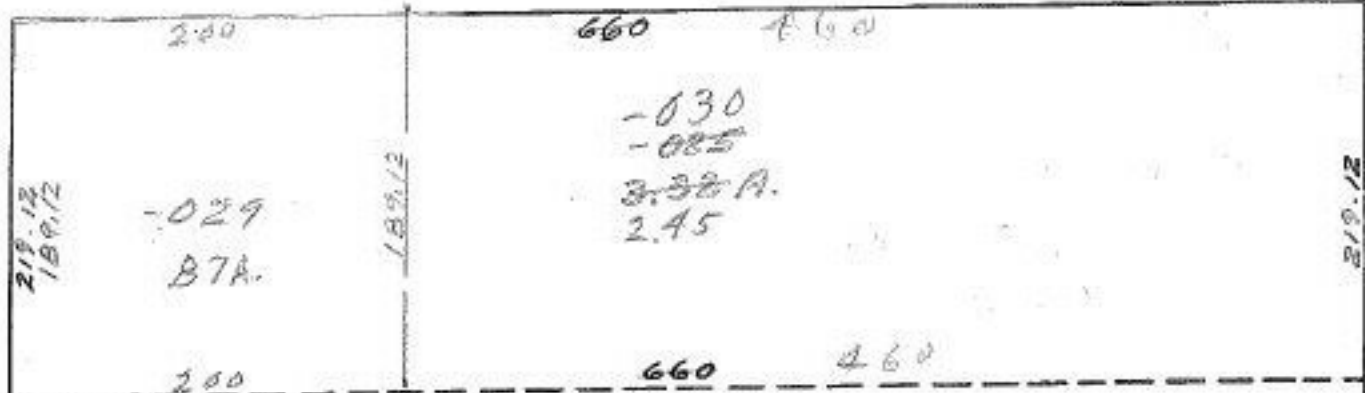

3865

APPROVED
 LORAIN CO.
 MAP DEPT.
 DATE 5/26/70
 9-00-065-B
 BY
 R. V. Kelling

RD. 460

438.24

219.12

UNRECORDED

