


#3912

#3912

540
 2110
 210
 $74.3 \times 50 = 47000$ (1)
 1200 (2)
 1000 (3)
 $130 \times 70 = 11700$ (1A)
 33000 (3)
 900 (16)
 $103,450 \text{ sq ft}$
 $103,450 \div 43.5 = 2,367.10$

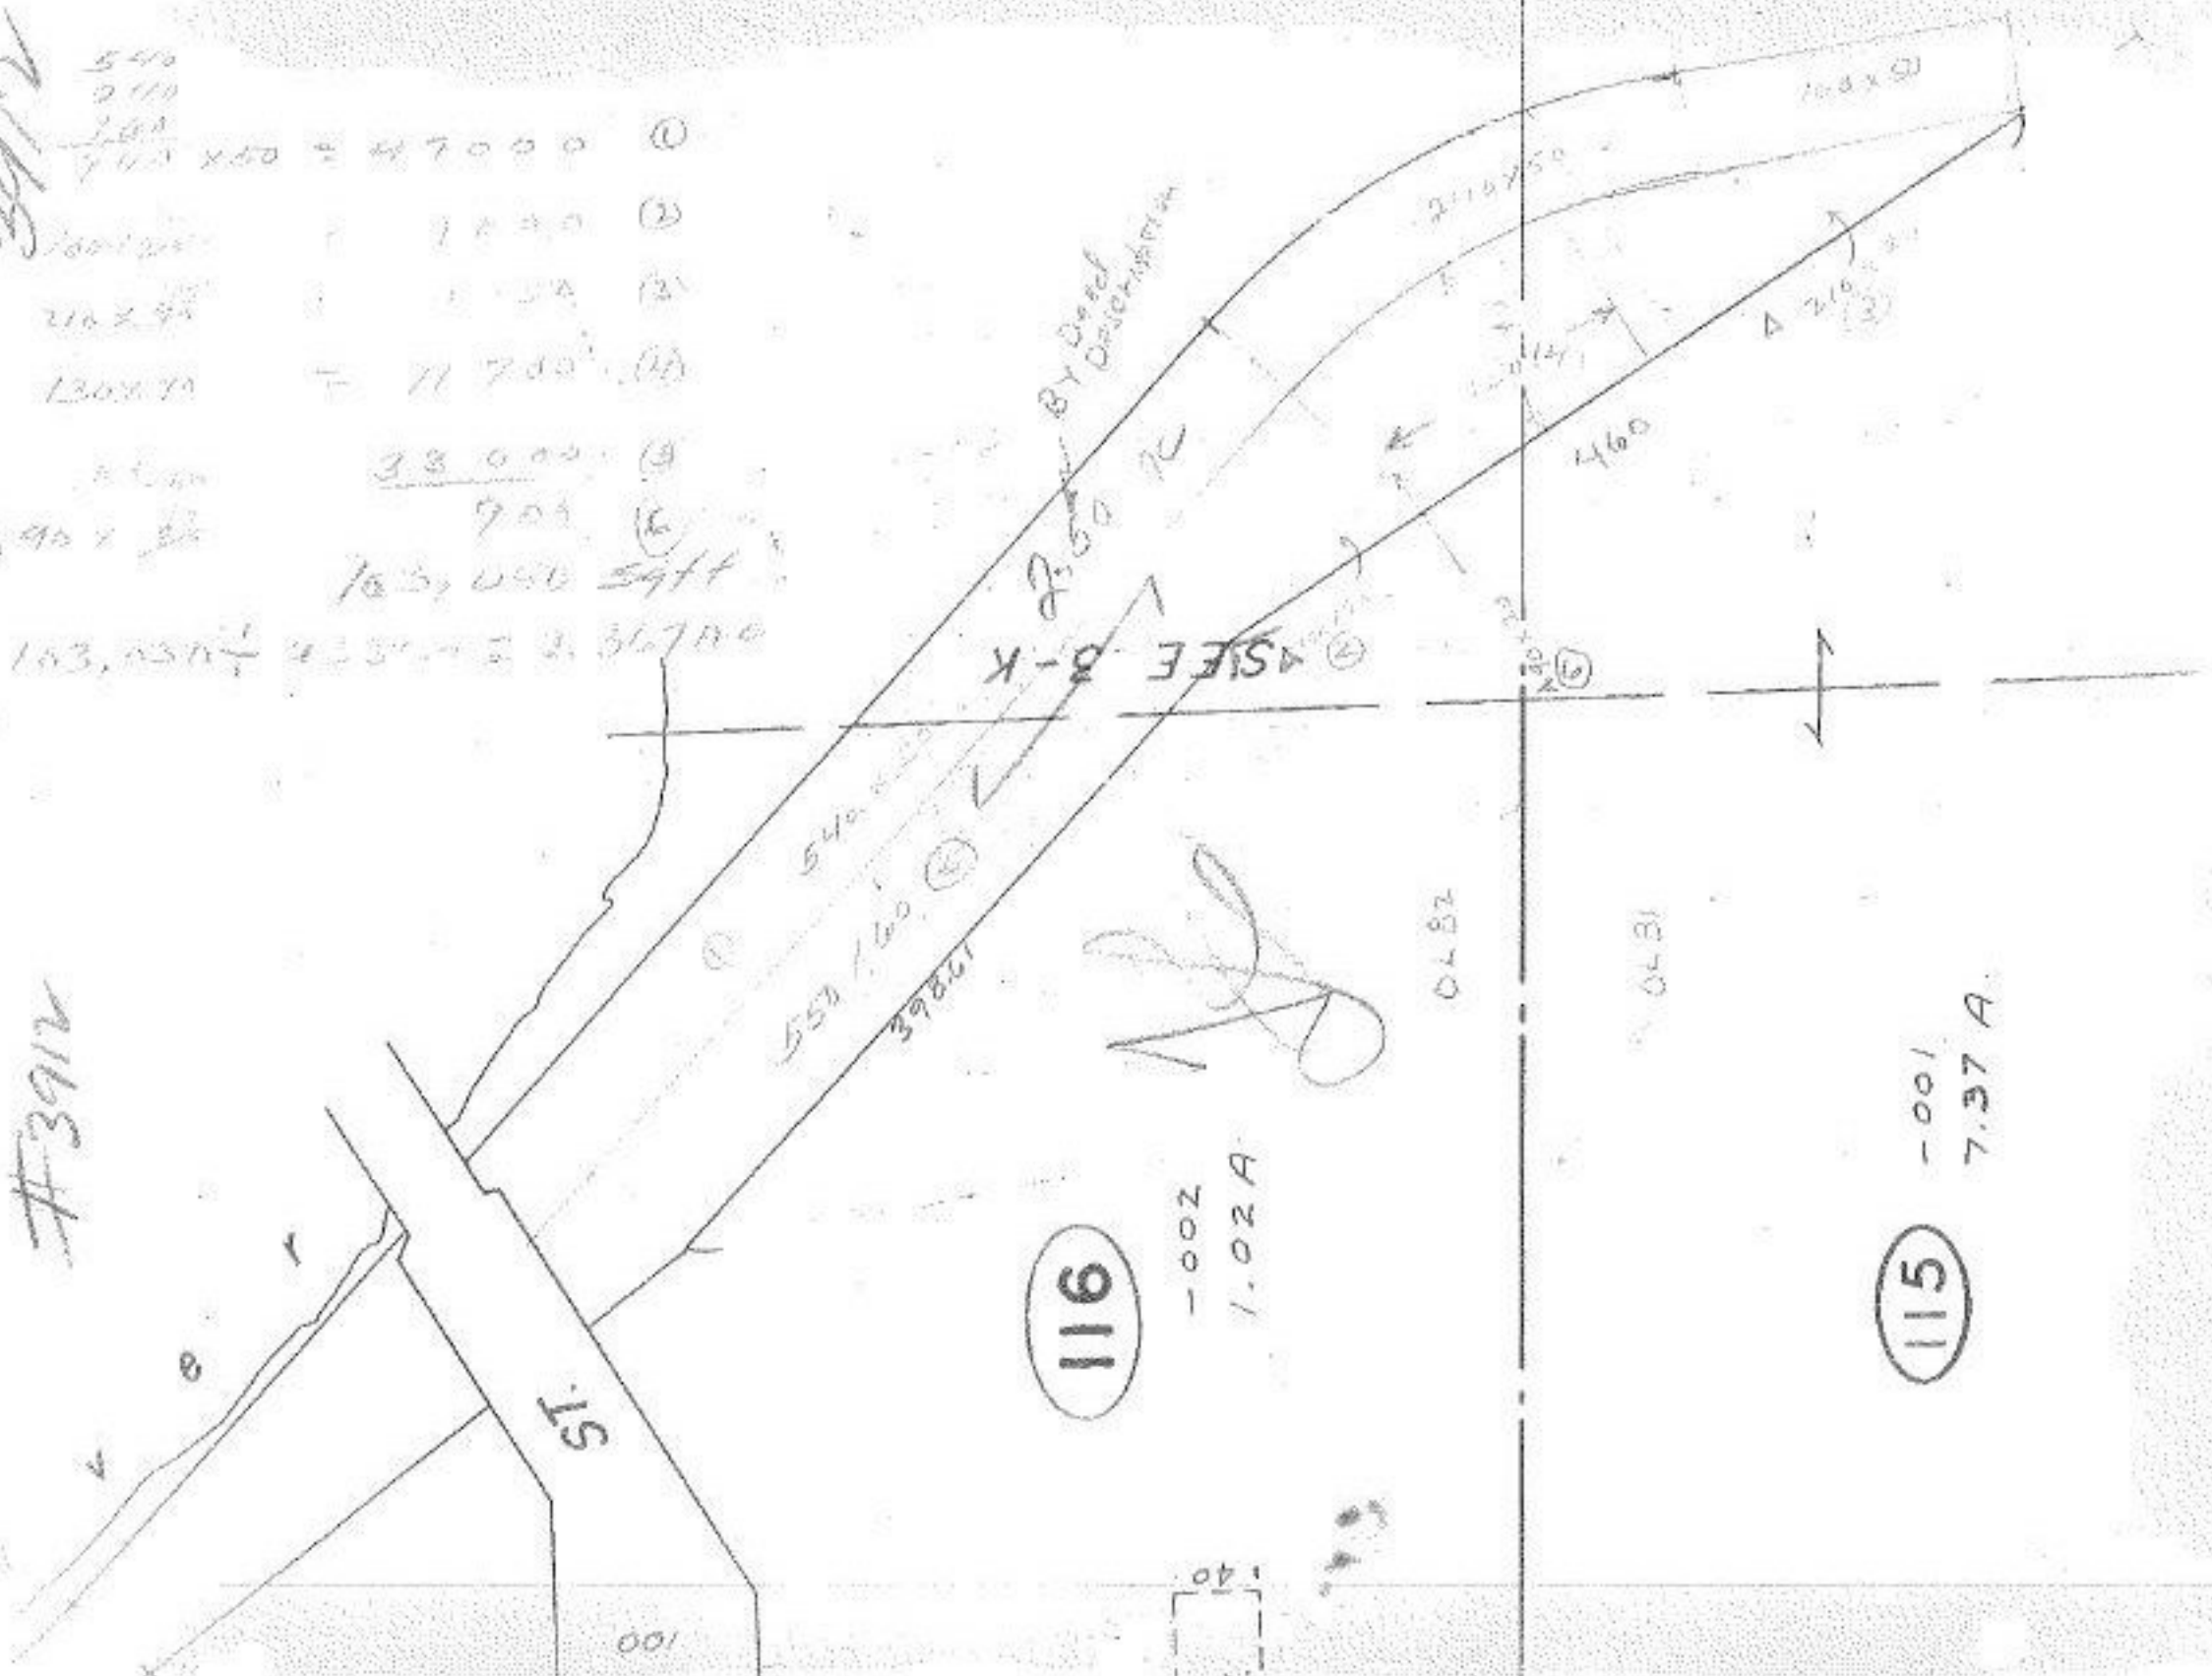

116

-002
1.02 A

115

-001
7.37 A